


EXHIBIT B

T37S, R32.5E, W.M.
Harney County, Oregon

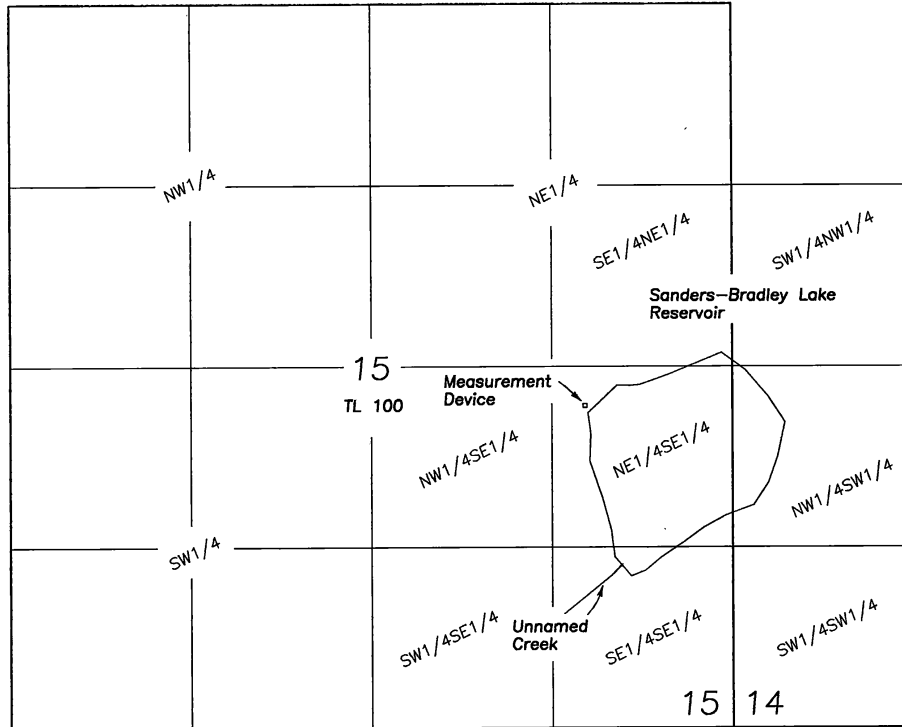

SCALE 1"=1320'

Outlet is located 2340' North & 1070' West of the
SE corner of Section 15.

Measuring device is located 7' North of the Outlet.

FINAL PROOF SURVEY
CLAIM OF BENEFICIAL USE
SANDERS-BRADLEY LAKE RESERVOIR

For

Bureau of Land Management

September 25, 2017

LEGEND

Application No. R-69346
Permit No. R-12942
Priority 9/28/1987

A portion of Tax Lot
37-32.5 TL100

NOTE: Tax Lot 100 is owned by the BLM
and is more that 17,000 acres.
No boundaries of the tax lot
can be shown.

NOTE: The preparation of this map
was for the purpose of identifying
the location of the proposed water
right and has no intent to provide
dimensions or location of property
ownership lines.

RECEIVED BY OWRD

NOV 03 2017

SALEM, OR

Prepared by
Cornerstone Surveying, Inc

P.O. BOX 33
JOHN DAY, OR. 97845
(541)575-1813

cornerstonesurvey@centurytel.net

