


T. 23 S., R. 25 E., W. M.

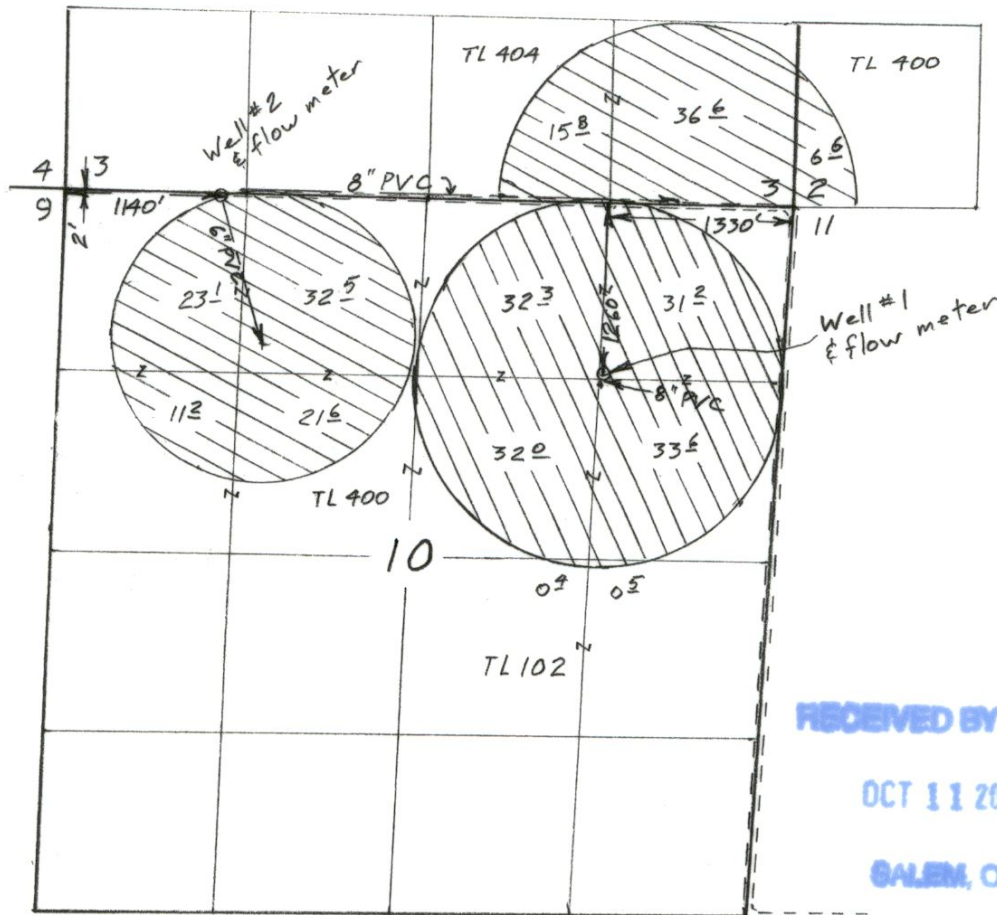

Scale 1" = 1320'
(4" = 1 mile)



RECEIVED BY OWRD

OCT 11 2012

SALEM, OR

Surveyed Nov. 17, 2011

- ⊗ Permit G-15926 130[±] acres
- ⊗ Permit G-16487 147[±] acres

App. G-16271

Per. G-15926

App. G-16625

Per. G-16487

Claim of Beneficial Use Map
for
Wayne & Michele Smith

This map is for the purpose of
locating a water right only
and has no intent to provide
legal dimensions or the location
of property lines.



Renewal Dec 31, 2013

ESTES SURVEYS, LLC
 PO Box 17518 60382 Arnold Rd
 Salem, OR 97305-7518 Bend, OR 97702
 (503) 585-7583 (541) 382-7391