


CLAIM OF BENEFICIAL USE MAP
FOR APPLICATION G-17142, PERMIT G-16632
IN THE NAME OF TOM AND MAUREEN RUGG
SEC 15, T1S, R32E, W.M., UMATILLA COUNTY

RECEIVED BY OWRD

JUN 15 2015

SALEM, OR

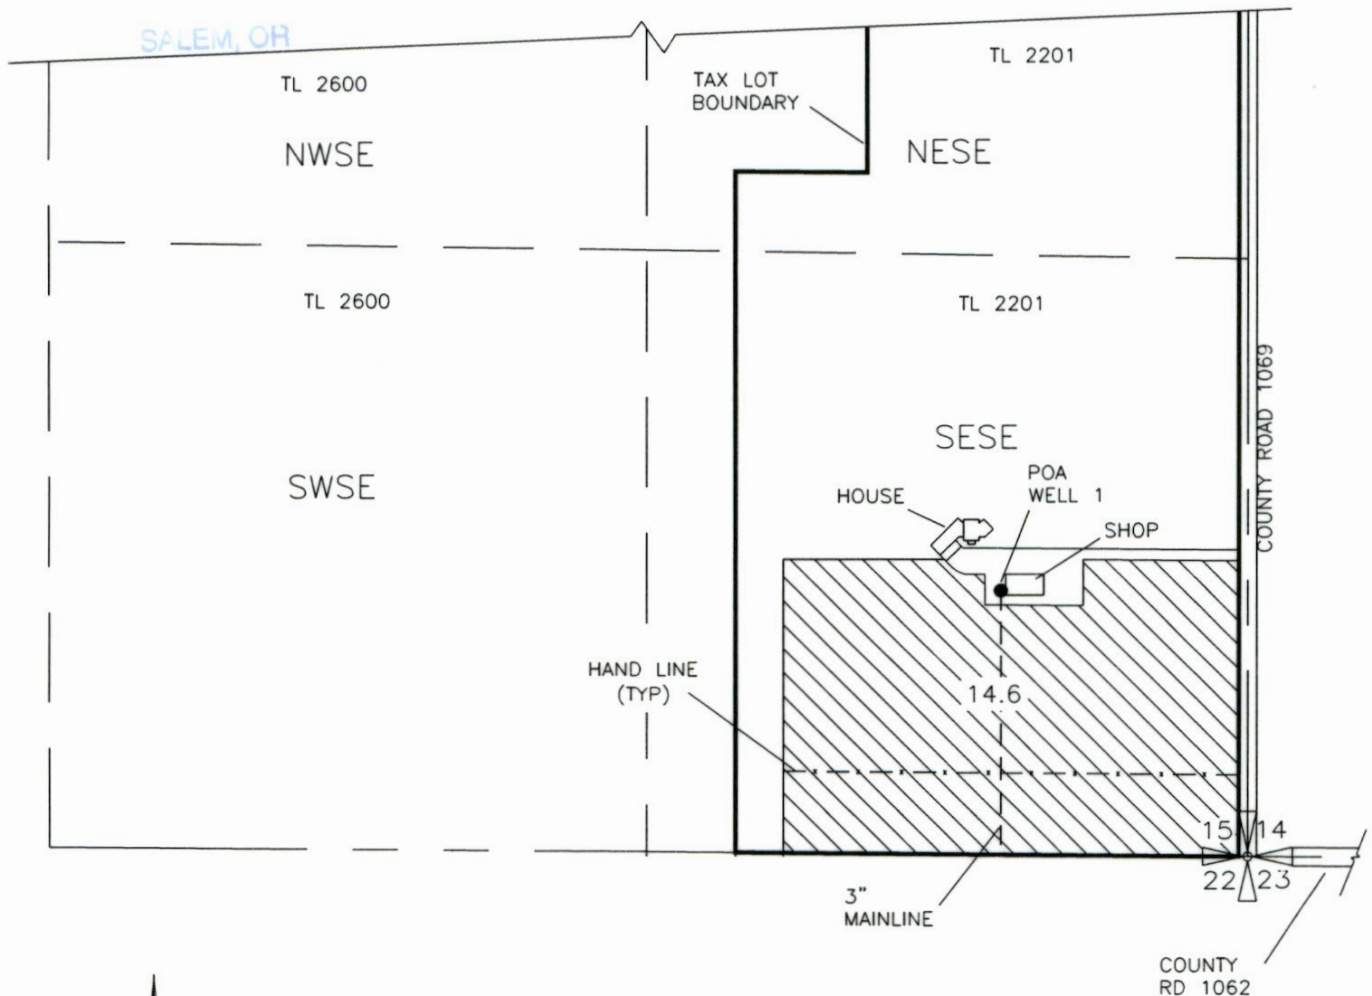


LEGEND




AREA IRRIGATED



POD, WELL 1, 10hp SUBMERSIBLE
PUMP & FLOW METER.
580 FT NORTH & 530 FT WEST OF
THE SE CORNER OF SECTION 15

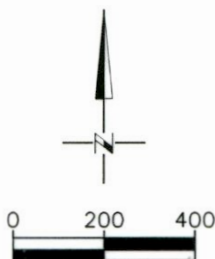

SCALE IN FEET

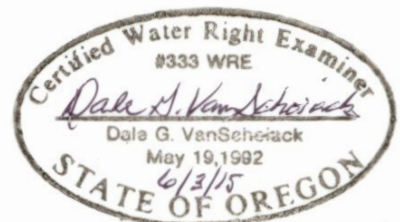

Renewed 6/30/16

NOTE:
THE PURPOSE OF THIS MAP IS TO IDENTIFY THE APPROXIMATE LOCATION OF THE WATER
RIGHT. IT IS NOT INTENDED TO PROVIDE INFORMATION RELATIVE TO THE LOCATION OF
PROPERTY OWNERSHIP BOUNDARY LINES. PIPELINE SIZES AND LOCATIONS WERE
PROVIDED BY FARM PERSONNEL AND HAVE NOT BEEN VERIFIED.

DGV Consulting, PLLC
PHONE (509) 627-8717
dalevconsulting@gmail.com
Date: May 16, 2015