


T 11 S, R 10 W, Section 21

LINCOLN COUNTY, OREGON

Scale: 1 inch = 400 feet

APPLICATION # 84524 PERMIT # 53763

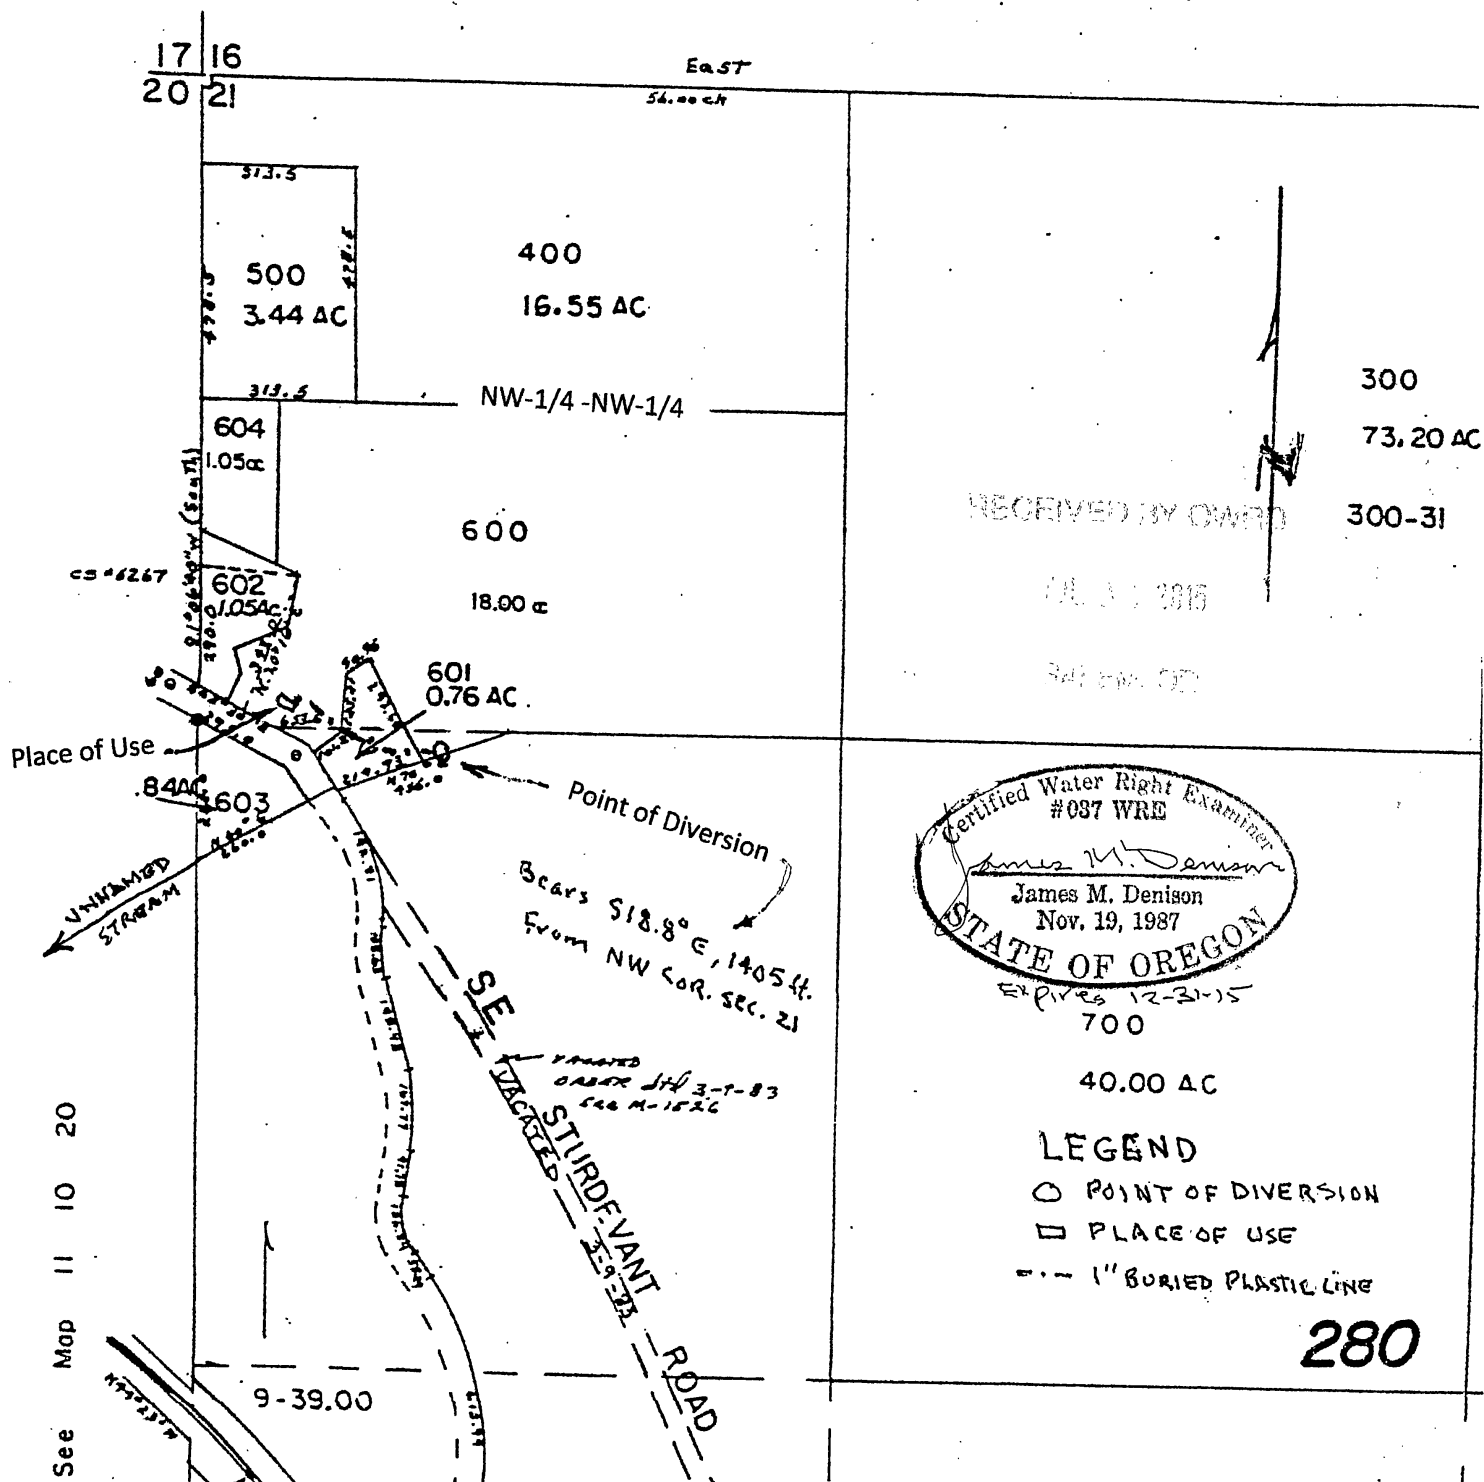

This map is not intended to provide legal dimensions or locations of property ownership lines