RECEIVED
SEP 23 1999
WATER RESOURCES DEPT.
SALEM, OREGON

T 4 N, R 24 E, W.M.

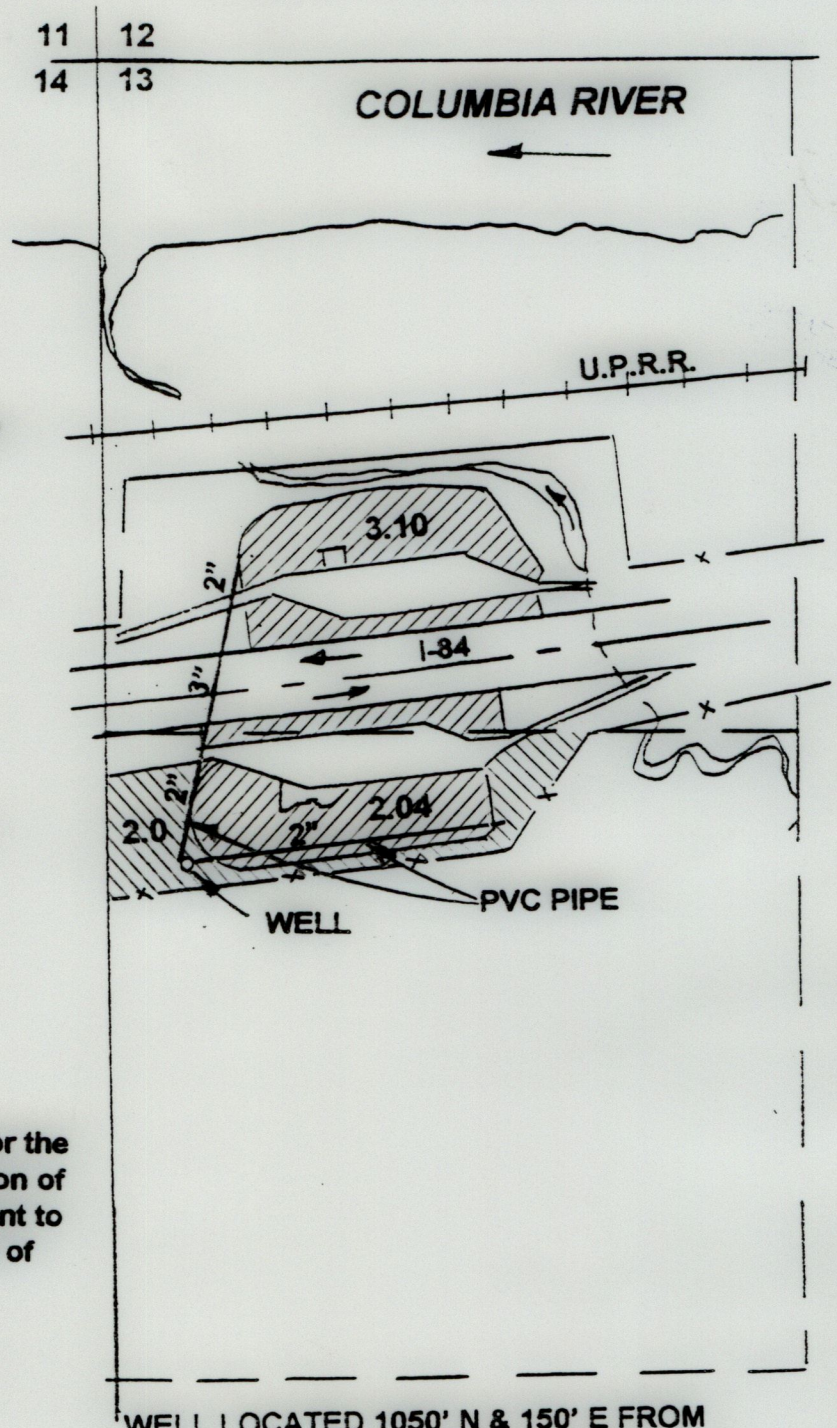

SCALE 1" = 660'

PRIMARY

SUPPLEMENTAL

The preparation of this map is for the purpose of identifying the location of water right only, and has no intent to provide dimensions or locations of property lines.

WELL LOCATED 1050' N & 150' E FROM W¼ COR, SECTION 13.

William N. Reynolds

Certified Water Right Examiner
184
William N. Reynolds
May 17, 1988
STATE OF OREGON

FINAL PROOF SURVEY

OREGON DEPARTMENT OF TRANSPORTATION