


# MAP TO ACCOMPANY APPLICATION FOR TRANSFER OF WATER RIGHT


TRANSFER NO. T-6489

## POINT OF DIVERSION TABLE

- #1 2250' SOUTH & 1420' WEST FROM  
NE COR. SEC. 4
- #2 3475' SOUTH & 500' EAST FROM  
NW COR. SEC. 3

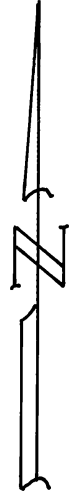

SCALE 1" = 1320'

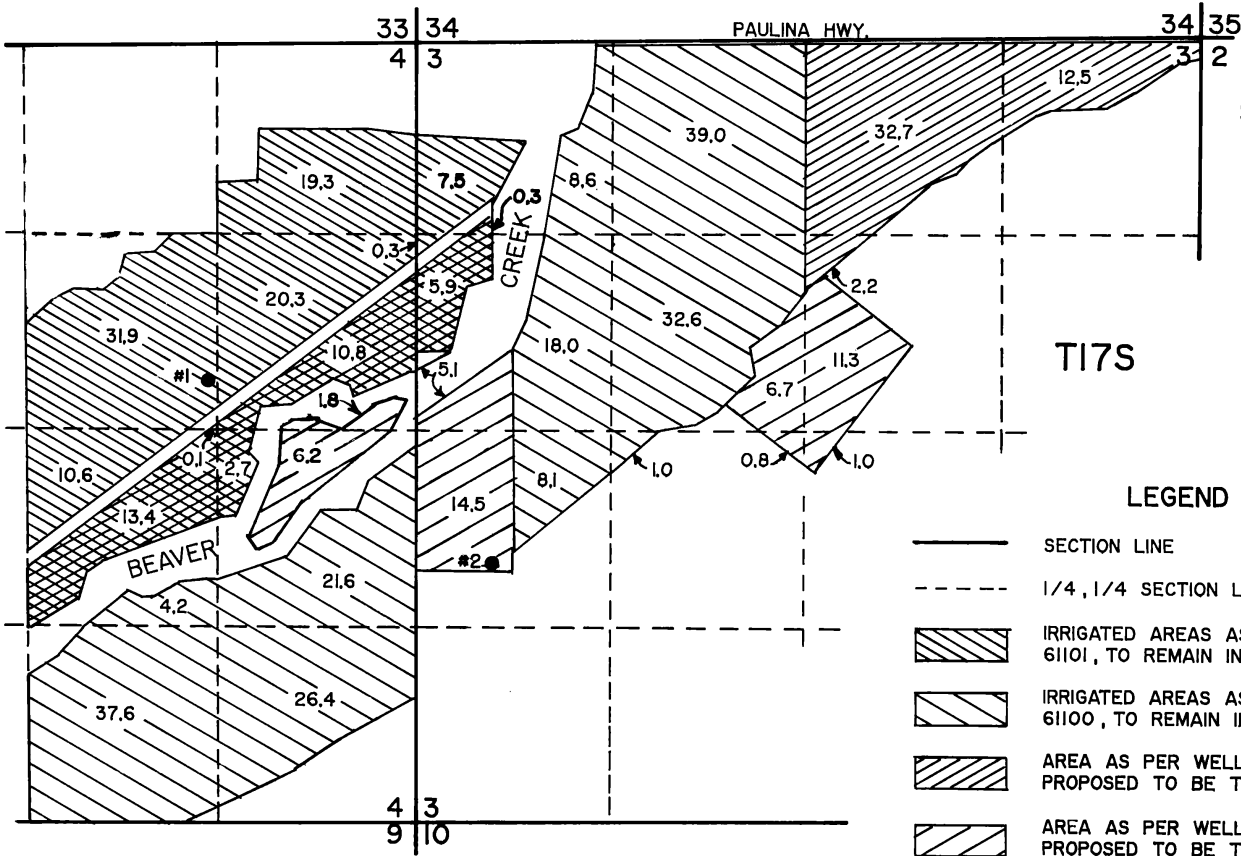

T17S

## LEGEND

- SECTION LINE
- - - 1/4, 1/4 SECTION LINE
- IRRIGATED AREAS AS PER WELL 1, CERT. 61101, TO REMAIN IN PLACE
- IRRIGATED AREAS AS PER WELL 2, CERT. 61100, TO REMAIN IN PLACE
- AREA AS PER WELL 2, CERT. 61100, PROPOSED TO BE TRANSFERRED OUT
- AREA AS PER WELL 2, CERT. 61100 PROPOSED TO BE TRANSFERRED IN
- AREA UNDER CERT. 61101 PROPOSED TO CHANGE P.O.D. FROM WELL 1 TO WELL 2
- #1 WELL POINT OF DIVERSION AS NOTED IN TABLE

R23E



## APPLICANT :

PAULINA RANCH  
P.O. BOX 46  
PAULINA, OREGON 97751  
(503) 477-3111

## PREPARED BY :

ANDERSON ENGINEERING & SURVEYING  
344 SW 7TH STREET  
REDMOND, OREGON 97756  
(503) 923-4307  
FEB. 1991 SHEET 1 OF 1

NOTE: PREPARATION OF THIS MAP IS FOR IDENTIFYING PROPOSED WATER RIGHTS ONLY. IT HAS NO INTENT TO PROVIDE LOCATIONS OR DIMENSIONS OF PROPERTY BOUNDARIES.

**FINAL PROOF SURVEY**  
**UNDER**  
**TRANSFER NO. T-6489**  
**IN THE NAME OF PAULINA RANCH INC.**

SPECIAL ORDER VOL. 46, PG. 275-277 DATED MAY 4, 1992  
 SURVEYED APRIL 10, 1995








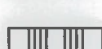
T17S, R23E, W.M.

**RECEIVED**

SEP 05 1995



WATER RESOURCES DEPT.  
 SALEM, OREGON

**LEGEND**

- SECTION LINE
- - - 1/4, 1/4 SECTION LINE
- - - EXISTING IRRIGATION MAINLINE
- ⊙#1 P.O.D - WELL AS NOTED. REFER TO NOTES FOR LOCATION.
- 179.5 AC.  EXISTING IRRIGATED AREA FROM WELL #2 AS PER CERT. NO. 67318.
- 17.6 AC.  AREA COVERED UNDER CERT. NO. 67318 NOT BEING IRRIGATED AT THE TIME OF THIS SURVEY.
- 88.9 AC.  EXISTING IRRIGATED AREA FROM WELL #1 AS PER CERT. NO. 67319.
- 1.0 AC.  AREA COVERED UNDER CERT. NO. 67319 NOT BEING IRRIGATED AT THE TIME OF THIS SURVEY.
- 59.6 AC.  EXISTING IRRIGATED AREA FROM WELL #2 AS PER TRANSFER T-6489.
- 21.0 AC.  AREA COVERED UNDER TRANSFER NO. T-6489 NOT BEING IRRIGATED AT THE TIME OF THIS SURVEY.
- 2.1 AC.  EXISTING IRRIGATED AREA FROM WELL #1 NOT COVERED UNDER TRANSFER NO. T-6489, CERT. NO. 67318, OR CERT. NO. 67319.
- 15.8 AC.  EXISTING IRRIGATED AREA FROM WELL #2 NOT COVERED UNDER TRANSFER NO. T-6489, CERT. NO. 67318, OR CERT. NO. 67319.



SCALE 1" = 1320'

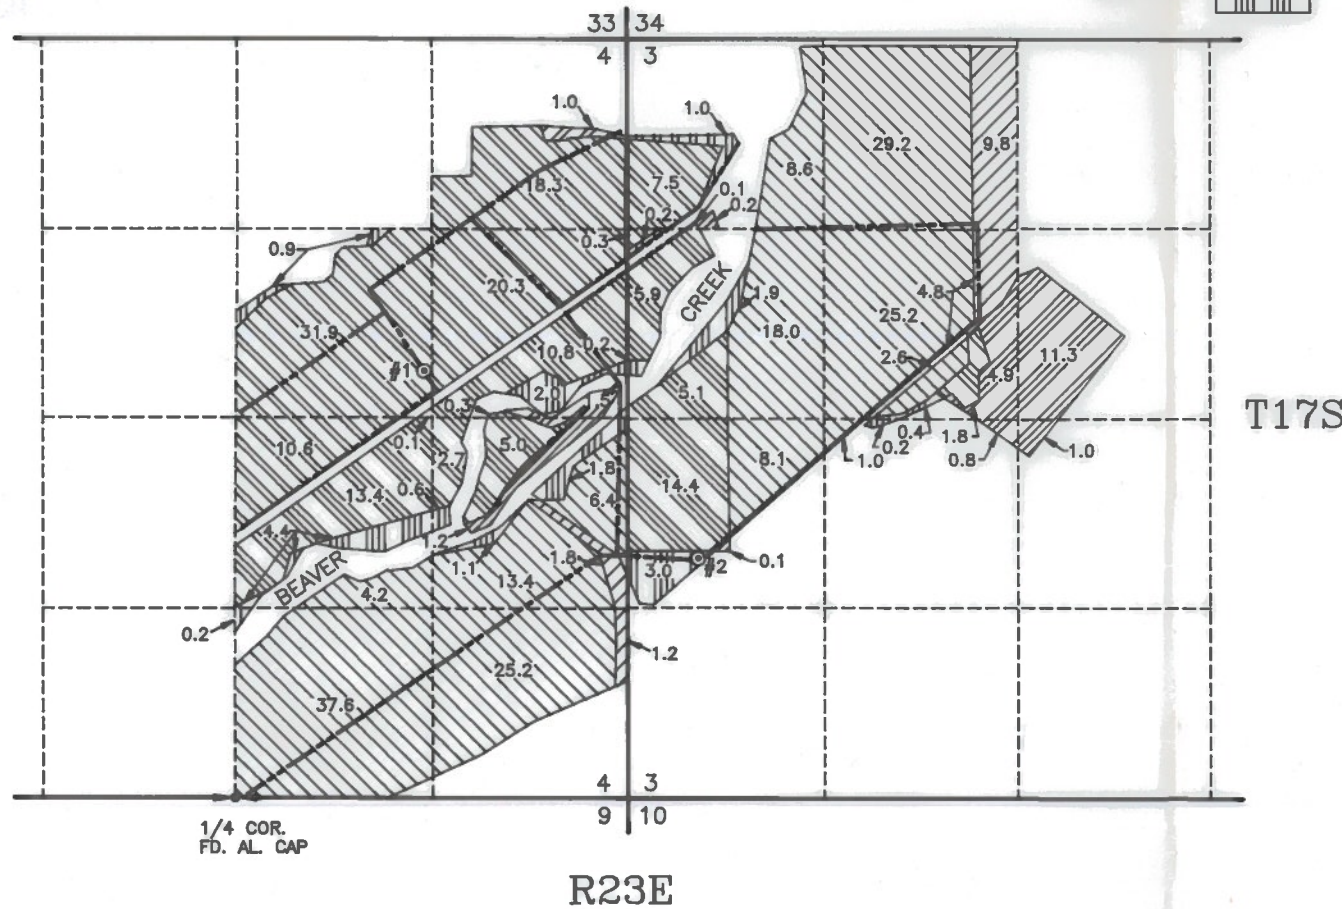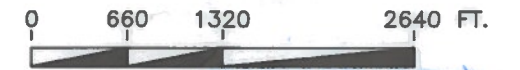

**NOTES**

PREPARATION OF THIS MAP IS FOR PURPOSES OF IDENTIFYING PROPOSED WATER RIGHTS ONLY. IT HAS NO INTENT TO PROVIDE DIMENSIONS OR LOCATIONS OF PROPERTY BOUNDARIES.

WELL #1 - POINT OF DIVERSION LOCATED 2935' NORTH & 1300' EAST OF THE 1/4 CORNER COMMON TO SECTIONS 4 & 9, T17S, R23E.

WELL #2 - POINT OF DIVERSION LOCATED 1650' NORTH & 3190' EAST OF THE 1/4 CORNER COMMON TO SECTIONS 4 & 9, T17S, R23E.



RENEWAL 6/30/96

PREPARED FOR:  
 PAULINA RANCH INC.  
 P.O. BOX 46  
 PAULINA, OREGON 97751  
 (503) 477-3111

PREPARED BY:  
 ANDERSON ENGINEERING & SURVEYING  
 539 SW 7TH STREET - P.O. BOX 419  
 REDMOND, OREGON 97756  
 (503) 923-4307  
 APRIL 10, 1995

SHEET 1 OF 1

COGO: 9501

ACAD: 9501FP