
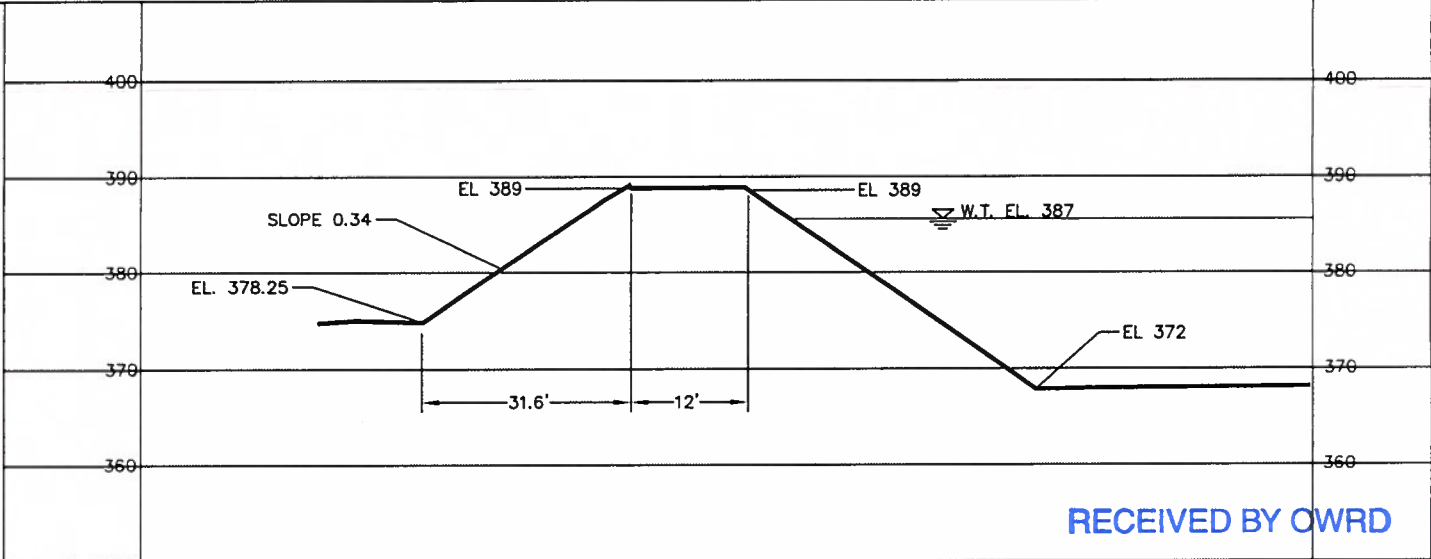
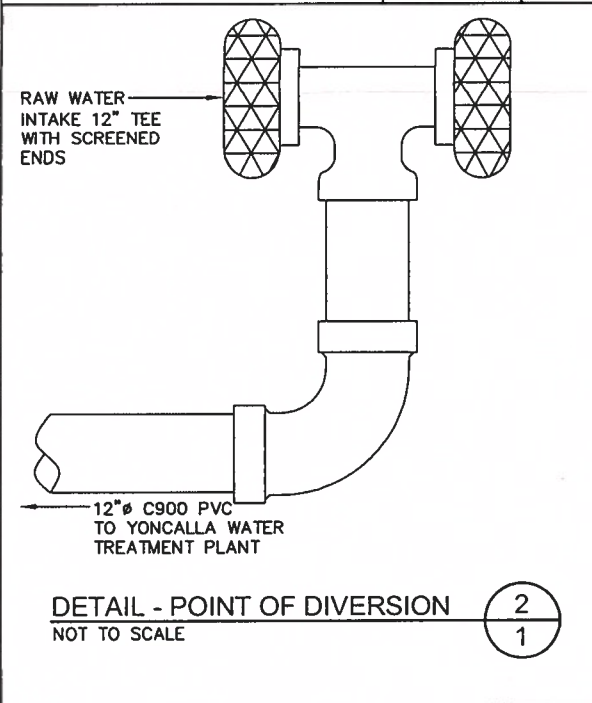


COBU MAP 918

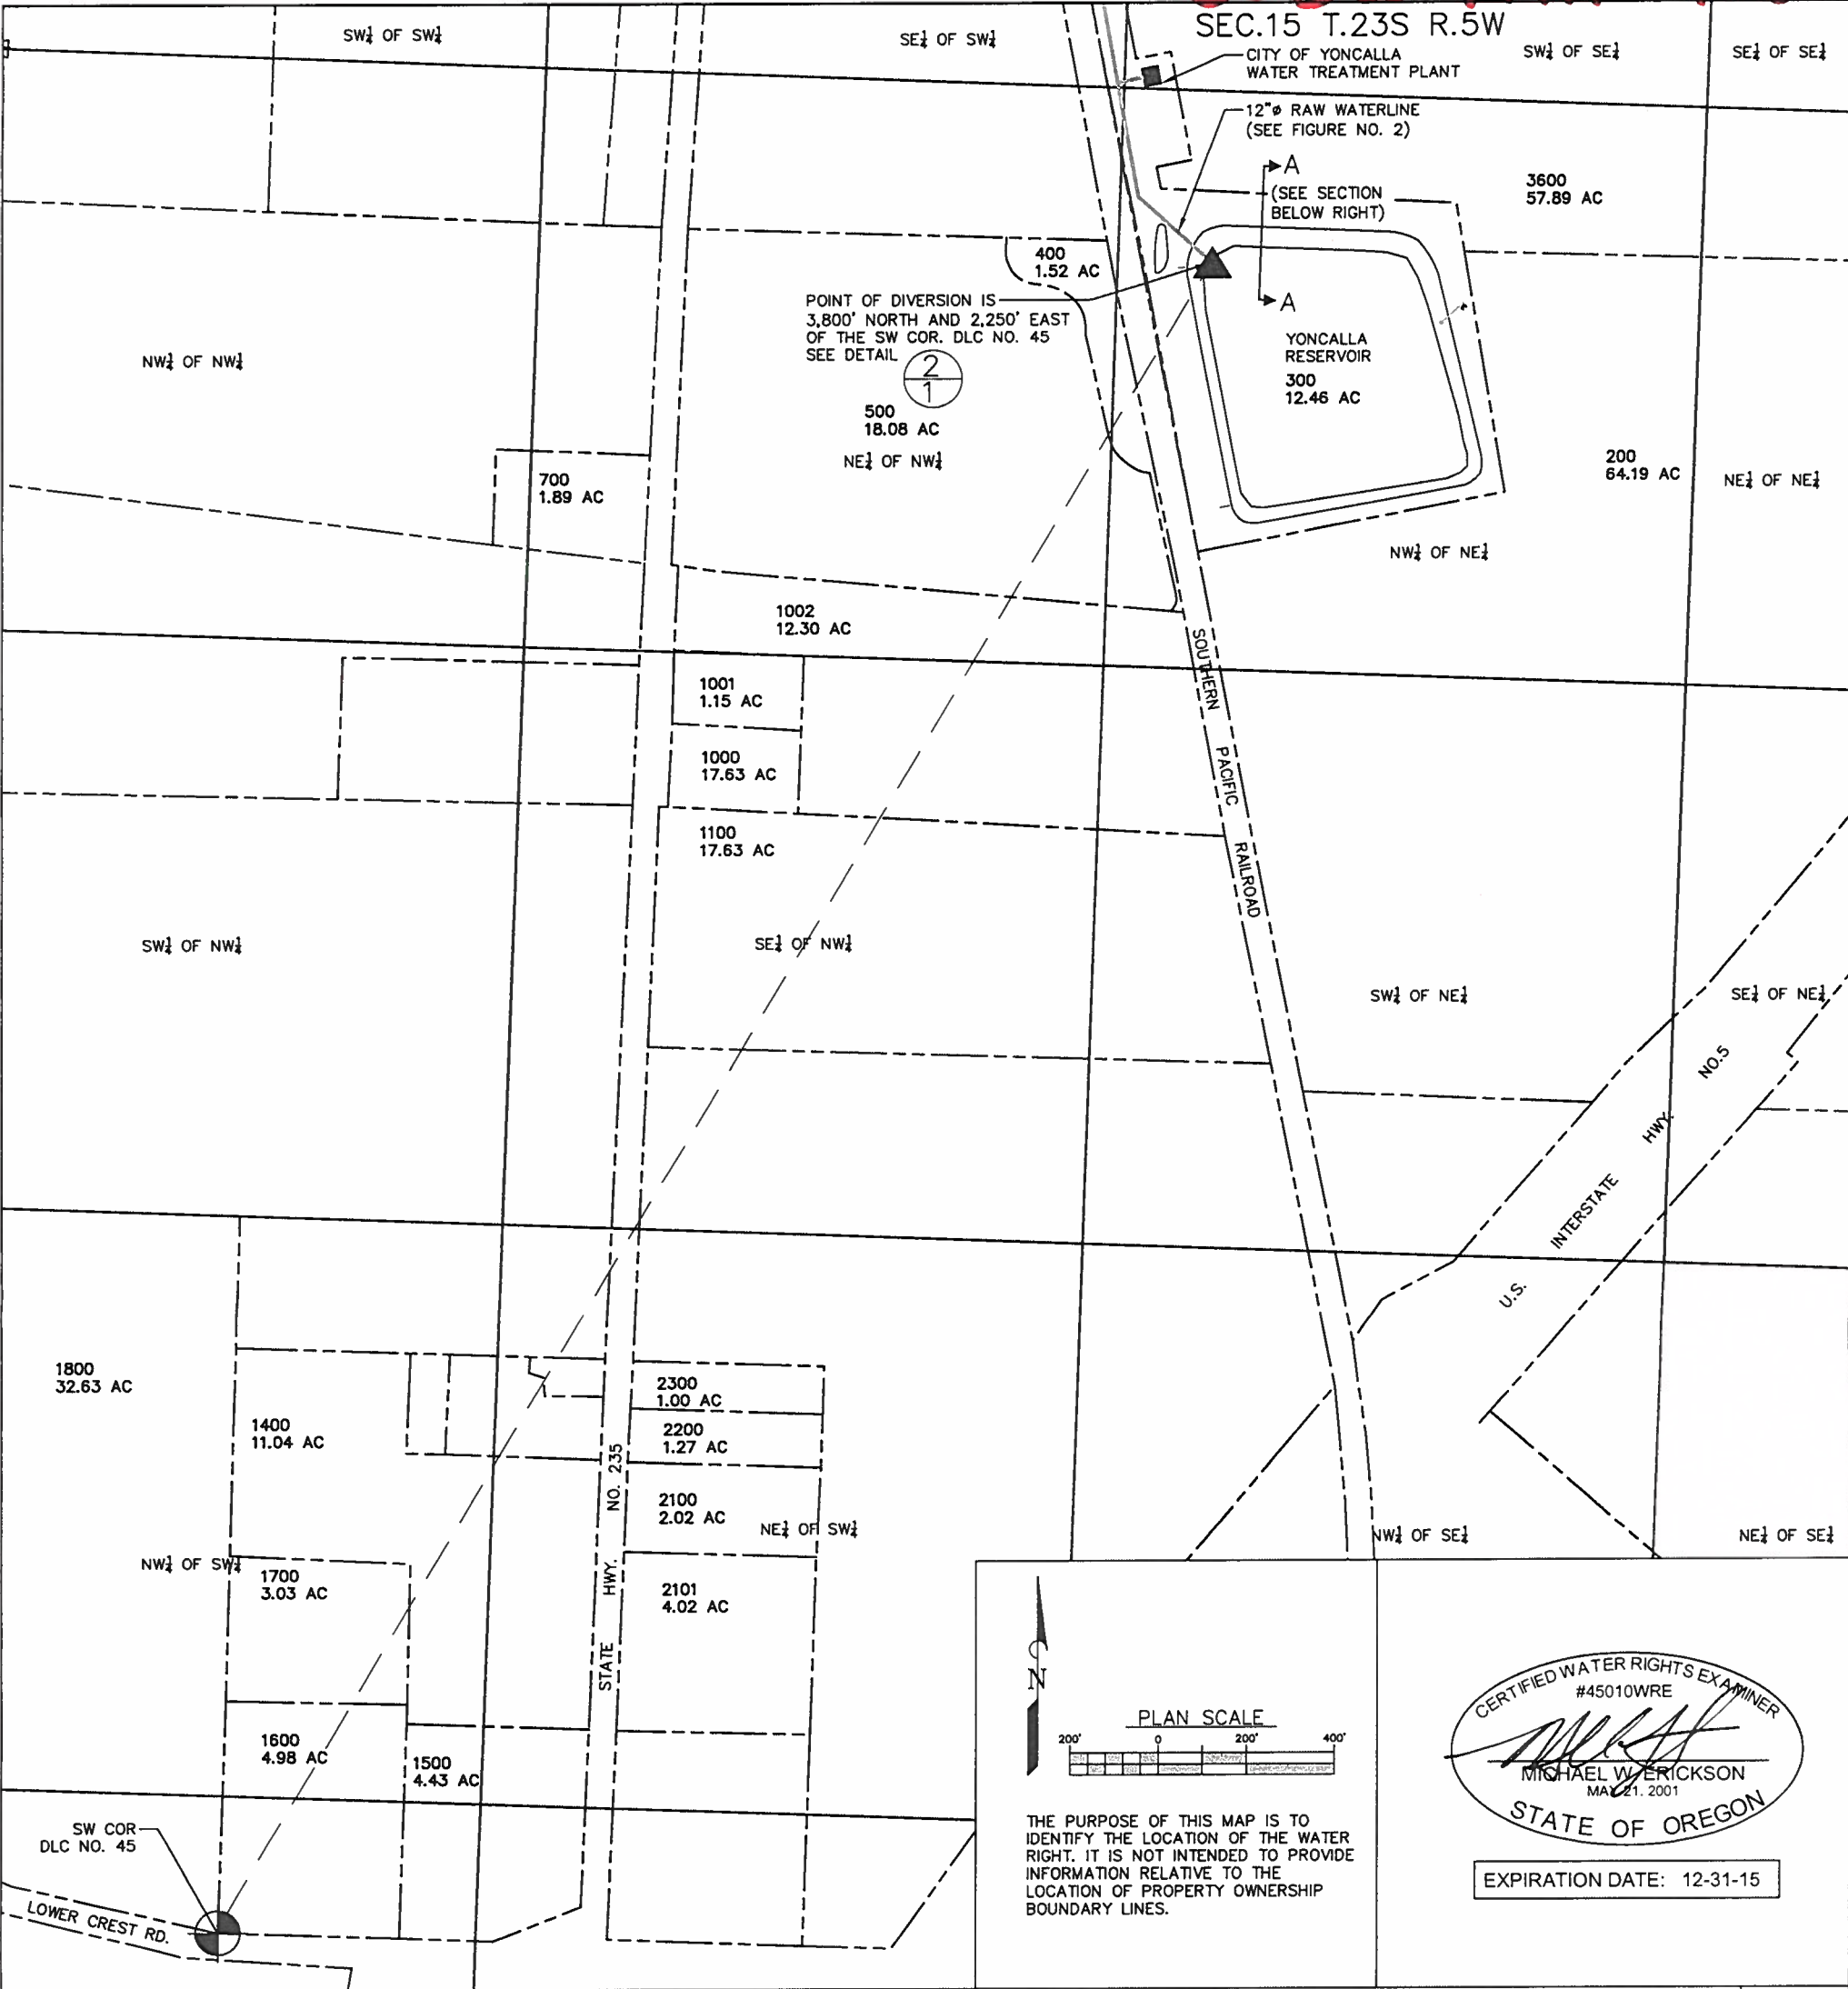


RECEIVED BY OWRD

JUN 29 2015

SALEM, OR

THE DYER PARTNERSHIP ENGINEERS & PLANNERS DATE: MAR. 2015 PROJECT NO.: 142.10	APPLICATION NO.: R-61040 PERMIT NO.: R-8320	CITY OF YONCALLA POD - LOCATION IN SEC. 15, T. 23S, R. 5W, W.M., DOUGLAS CO., OR. CLAIM OF BENEFICIAL USE	FIGURE NO. 1
--	--	--	------------------------

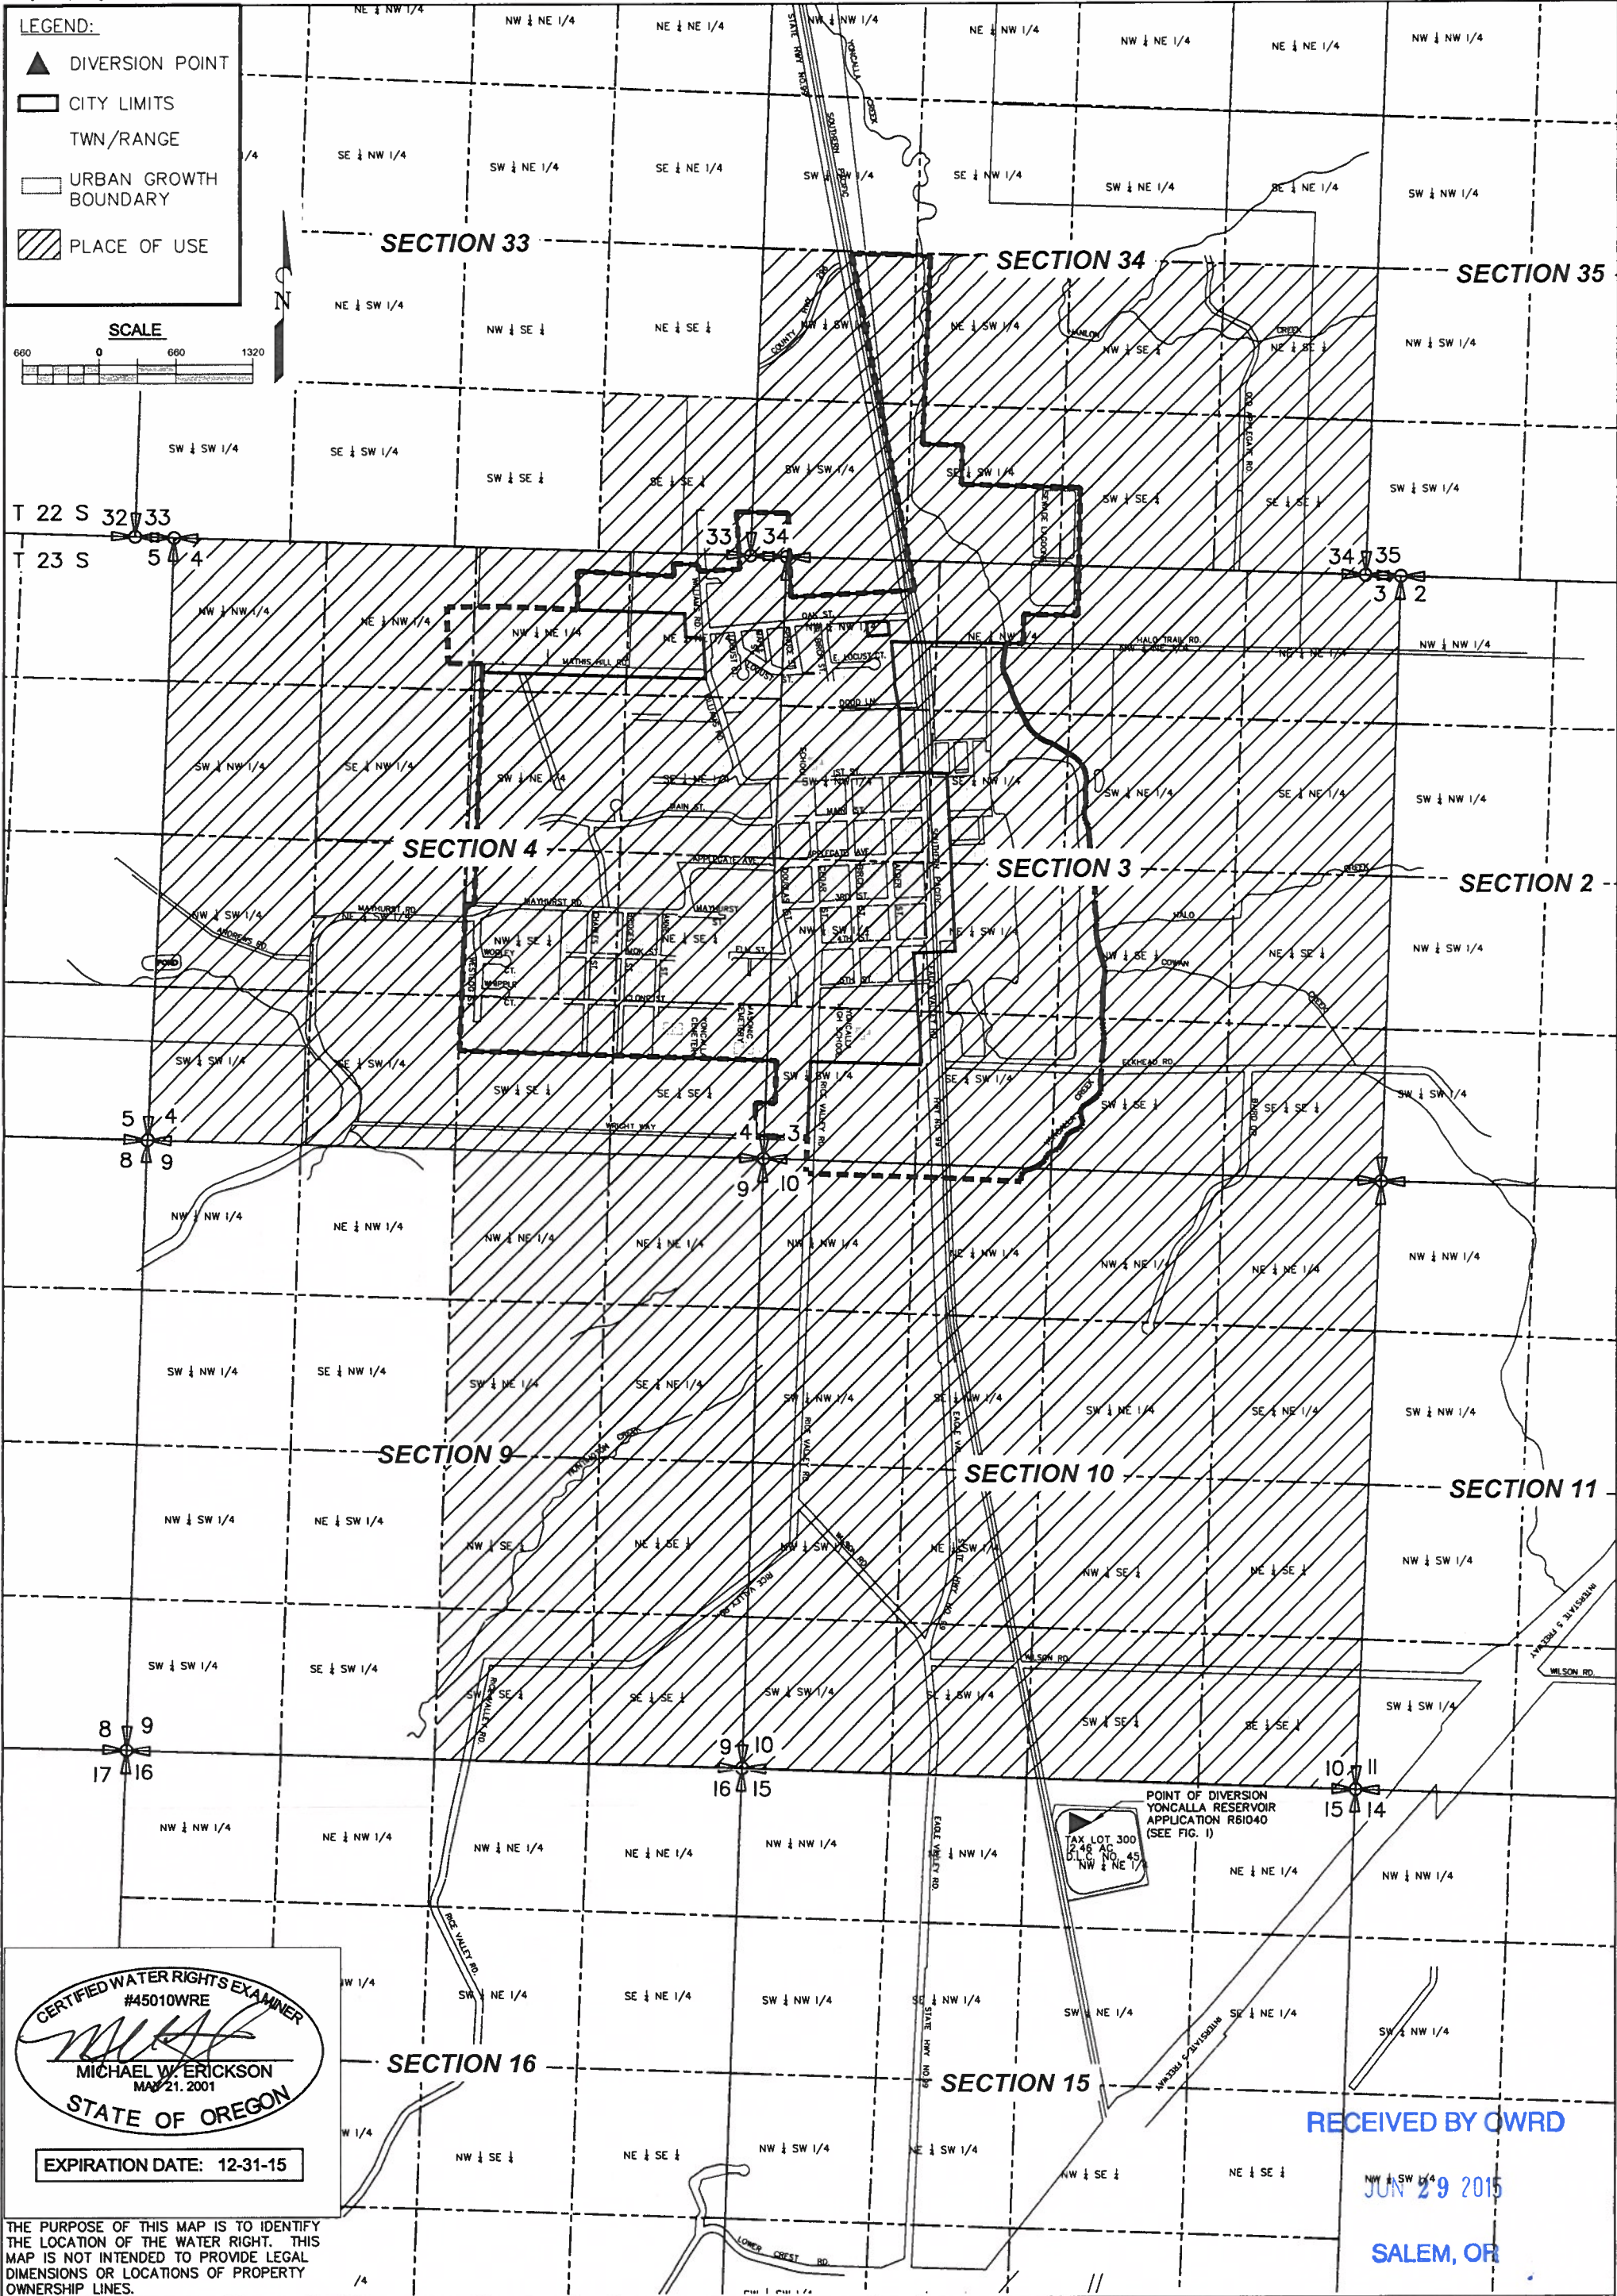

CERTIFIED WATER RIGHTS EXAMINER
#45010WRE
MICHAEL W. ERICKSON
MAY 21, 2001
STATE OF OREGON
EXPIRATION DATE: 12-31-15

THE PURPOSE OF THIS MAP IS TO IDENTIFY THE LOCATION OF THE WATER RIGHT. THIS MAP IS NOT INTENDED TO PROVIDE LEGAL DIMENSIONS OR LOCATIONS OF PROPERTY OWNERSHIP LINES.

THE DYER PARTNERSHIP
ENGINEERS & PLANNERS
DATE: MAR. 2015
PROJECT NO.: 142.10

APPLICATION NO.: R-61040
PERMIT NO.: R-8320

CITY OF YONCALLA
PLACE OF USE - LOCATED IN T.22S & T23S, R5W, W.M. DOUGLAS CO., OR.
CLAIM OF BENEFICIAL USE

FIGURE NO.
2

RECEIVED BY OWRD
JUN 29 2015
SALEM, OR