

**T16S, R12E,
SECTIONS 14, 15, 16, 21, 22
23, 26 AND 27, WM**

DESCHUTES COUNTY, OREGON

PAGE 1 OF 2

RECEIVED BY OWRD

JUN 26 2015

SALEM, OR


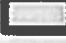
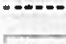




0 1,320 Feet
1" = 1,320'

RECEIVED BY OWRD

AUG 21 2015


SALEM, OR

-  Service Boundary
-  Section
-  Quarter Quarter
-  Taxlot
-  Well

930



RENEWAL DATE 12/31/2015

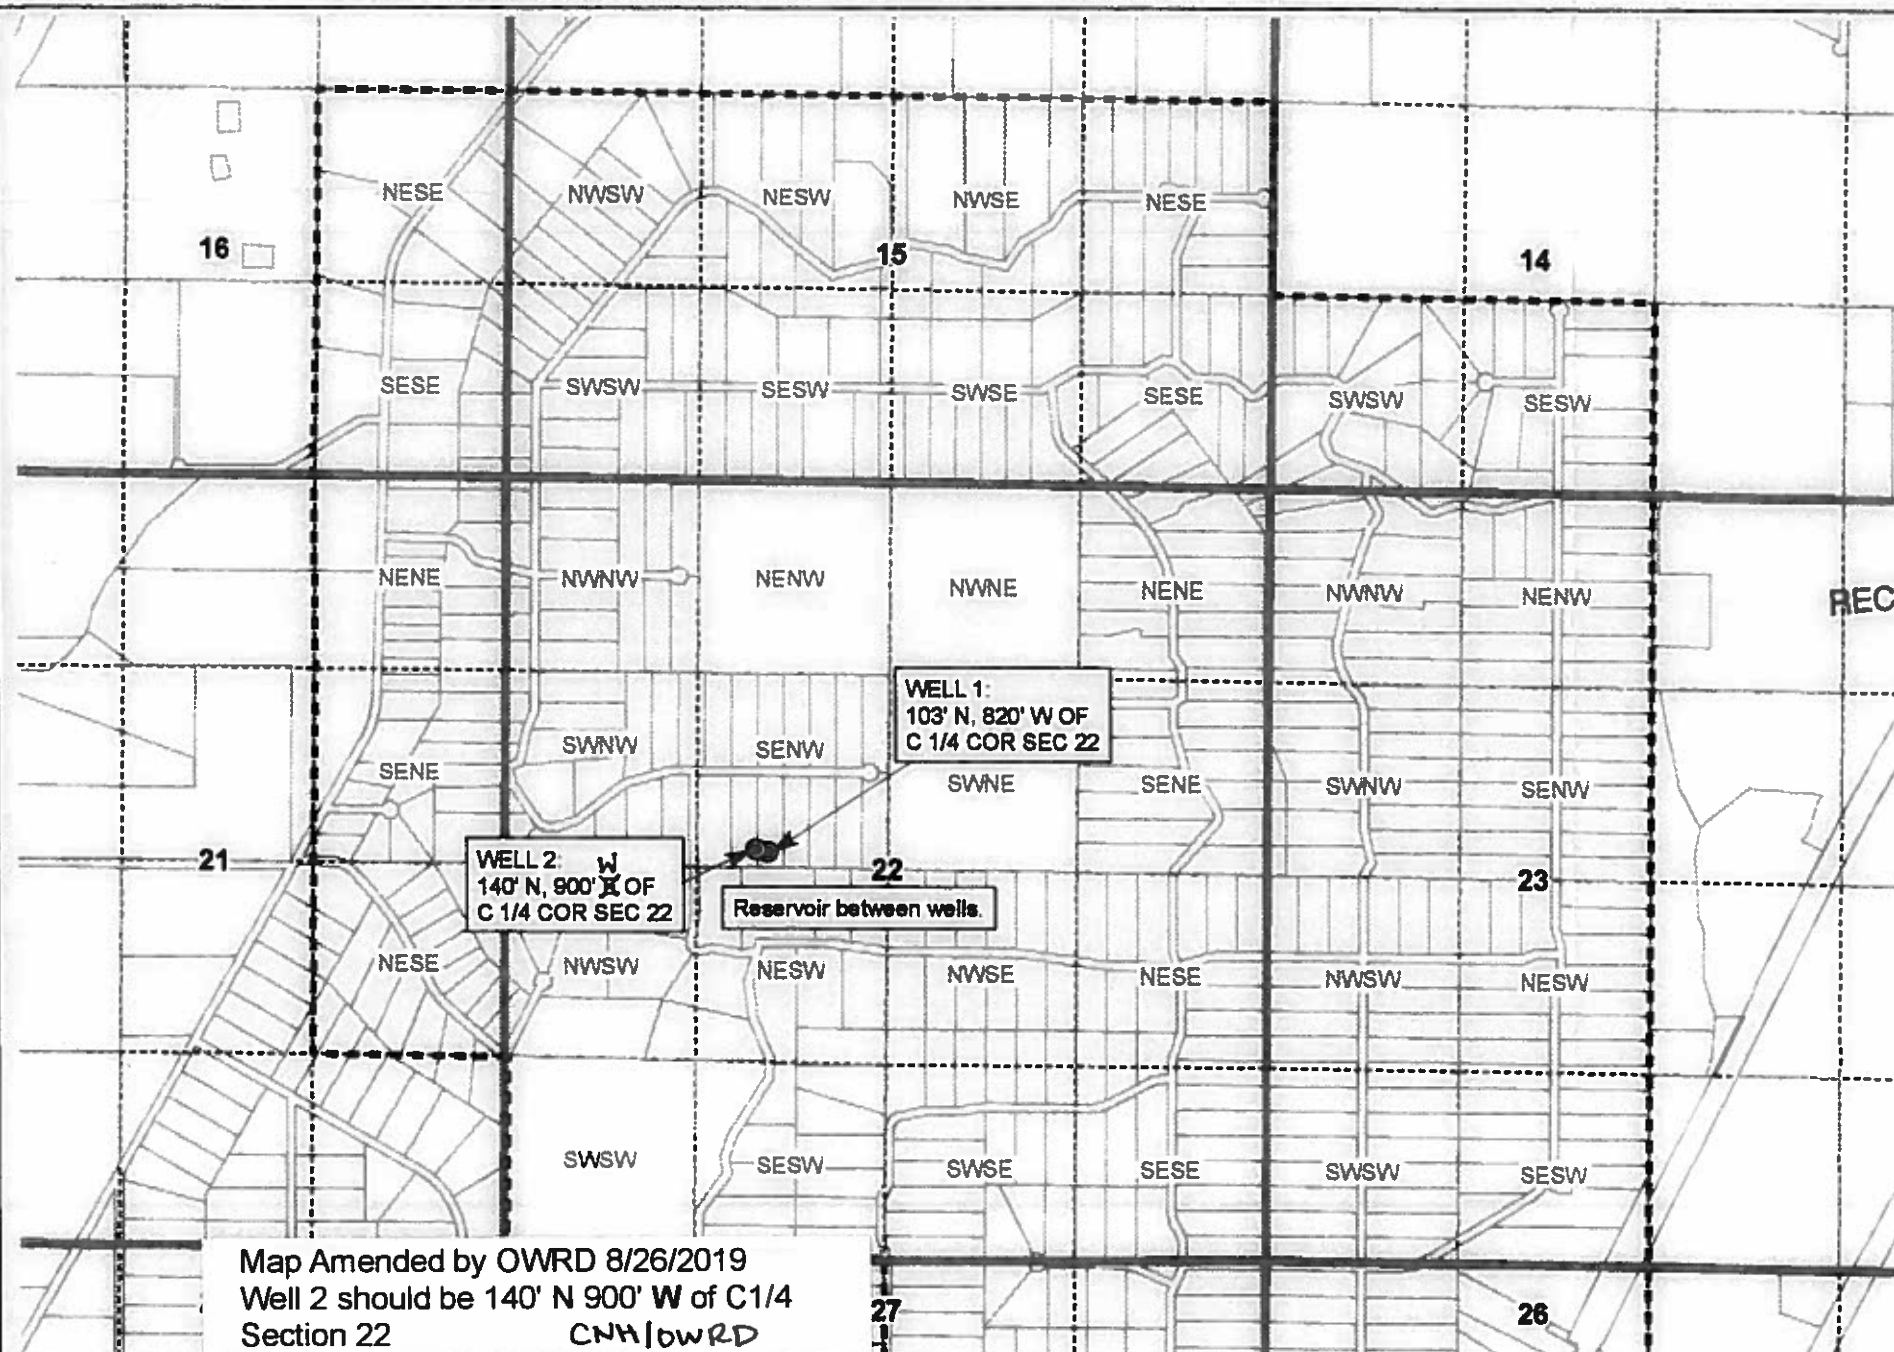

Map Amended by OWRD 8/26/2019
Well 2 should be 140' N 900' W of C1/4
Section 22
CNY/DWRD

CLAIM OF BENEFICIAL USE MAP
Long Butte Water System, Inc

NOTE: THIS MAP IS NOT INTENDED TO
PROVIDE LEGAL DIMENSIONS OR LOCATIONS
OF PROPERTY OWNERSHIP LINES.

WATER RIGHT SERVICES, LLC

PO BOX 1830, BEND, OR 97709
CCB# 197121 www.oregonwater.us
541-389-2837 JOHNSHORT@USA.COM

AP G-12662

PERMIT G-11381

PROJECT #15009

FEBRUARY 28, 2015

**T16S, R12E,
SECTIONS 14, 15, 16, 21, 22
23, 26 AND 27, WM**

DESCHUTES COUNTY, OREGON

PAGE 2 OF 2



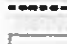


RECEIVED BY OWRD

JUN 26 2015

SALEM, OR

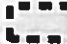


1,320 Feet
1" = 1,320'

-  Service Boundary
-  Section
-  Quarter Quarter
-  Taxlot
-  Well

930



RENEWAL DATE 12/31/2015

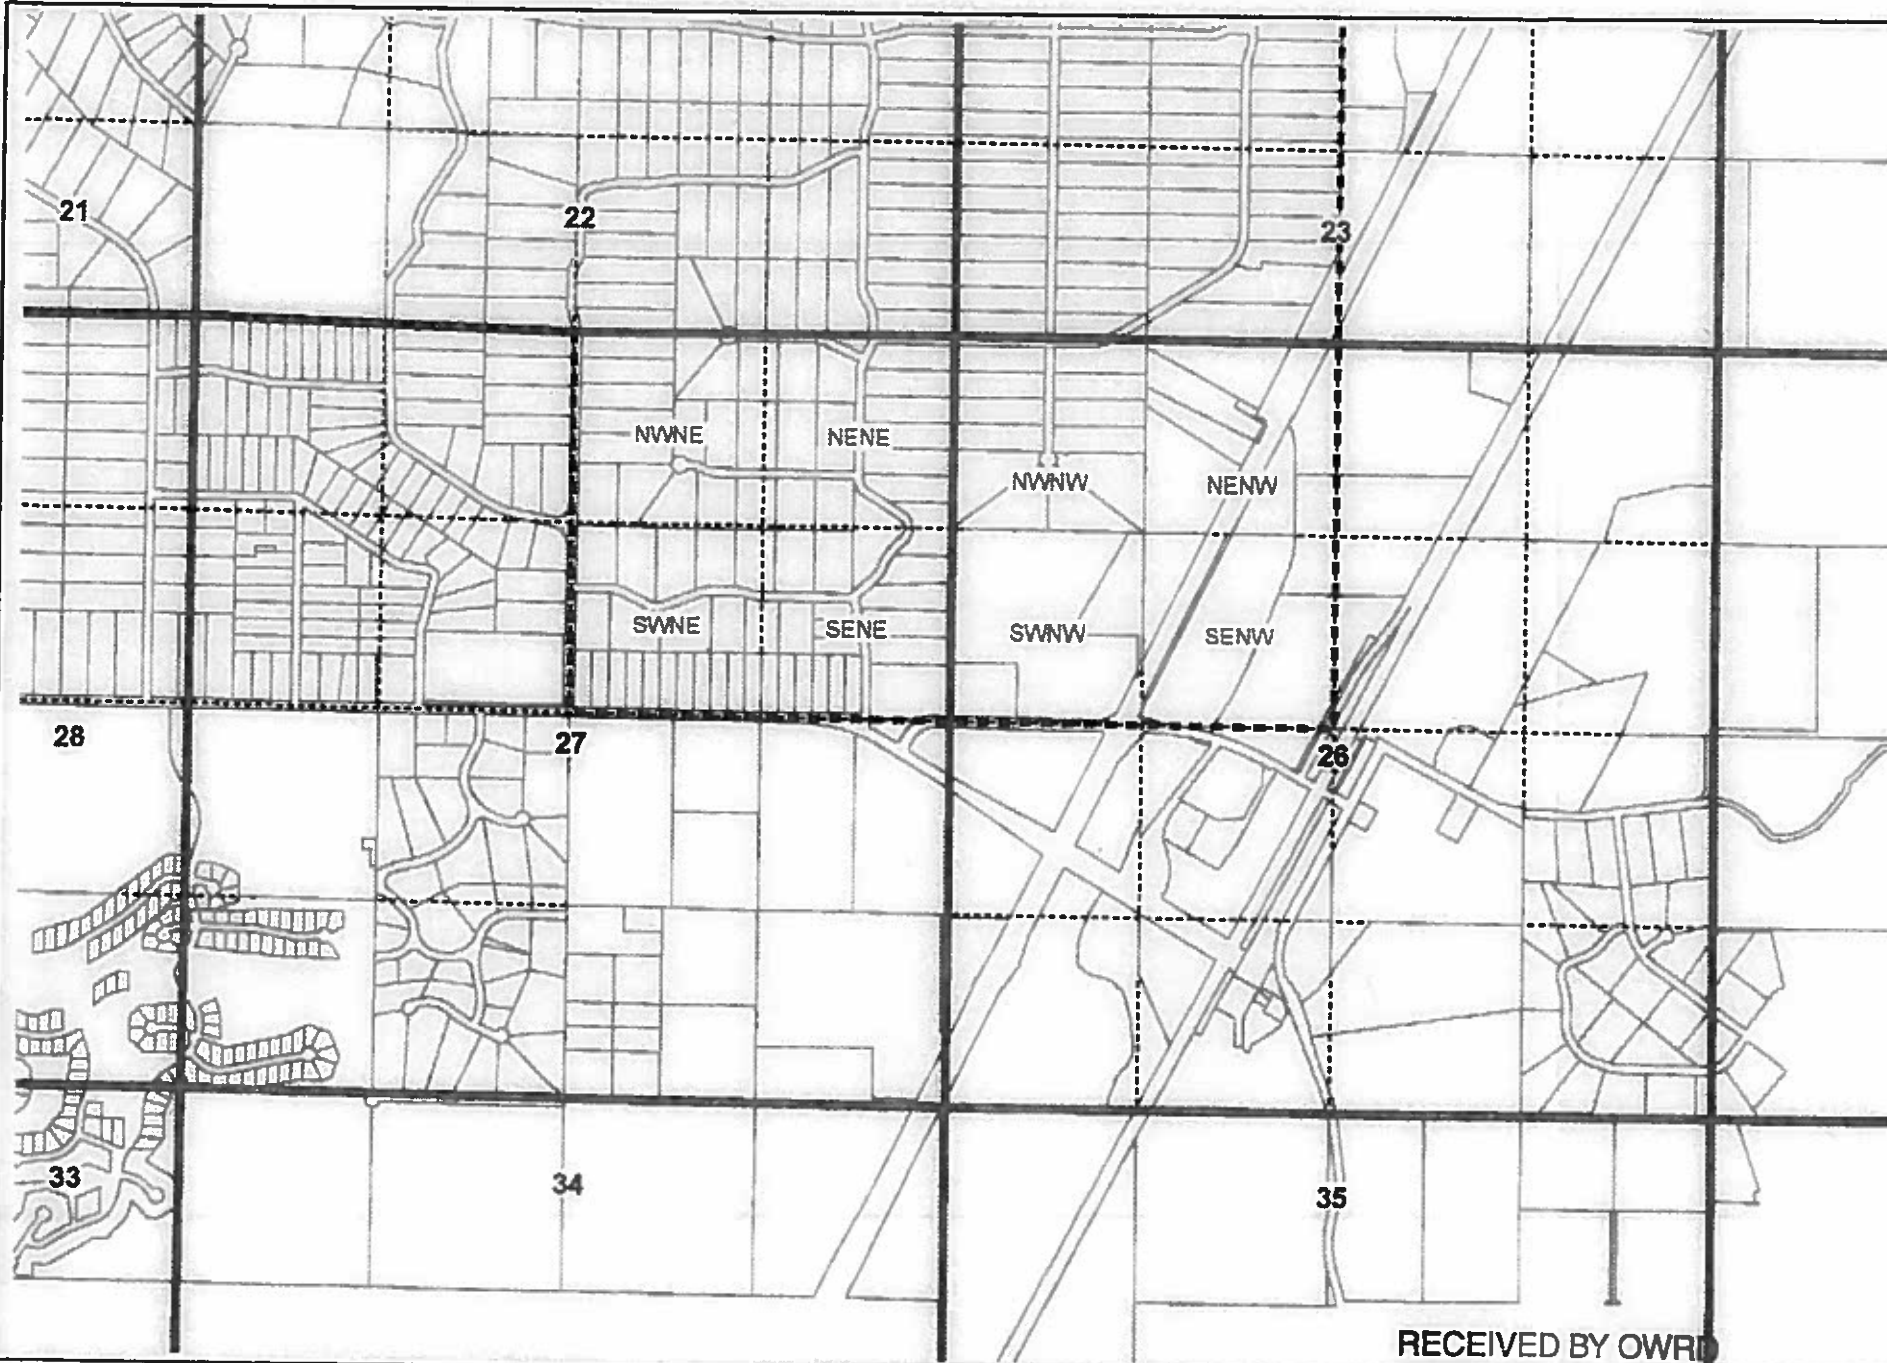

RECEIVED BY OWRD

CLAIM OF BENEFICIAL USE MAP
Long Butte Water System, Inc

NOTE: THIS MAP IS NOT INTENDED TO
PROVIDE LEGAL DIMENSIONS OR LOCATIONS
OF PROPERTY OWNERSHIP LINES.

AUG 21 2015

WATER RIGHT SERVICES, LLC

PO BOX 1830, BEND, OR 97709

CCB# 197121 www.oregonwater.us

541-389-2837 JOHNSHORT@USA.COM

SALEM, OR

AP G-12682

PERMIT G-11381

PROJECT #15009

FEBRUARY 28, 2015