



SECTIONS 17 & 20

T. 29 S., R. 14 W., W.M.

COOS COUNTY, OREGON

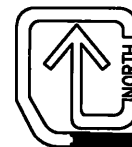

SCALE: 1" = 400'

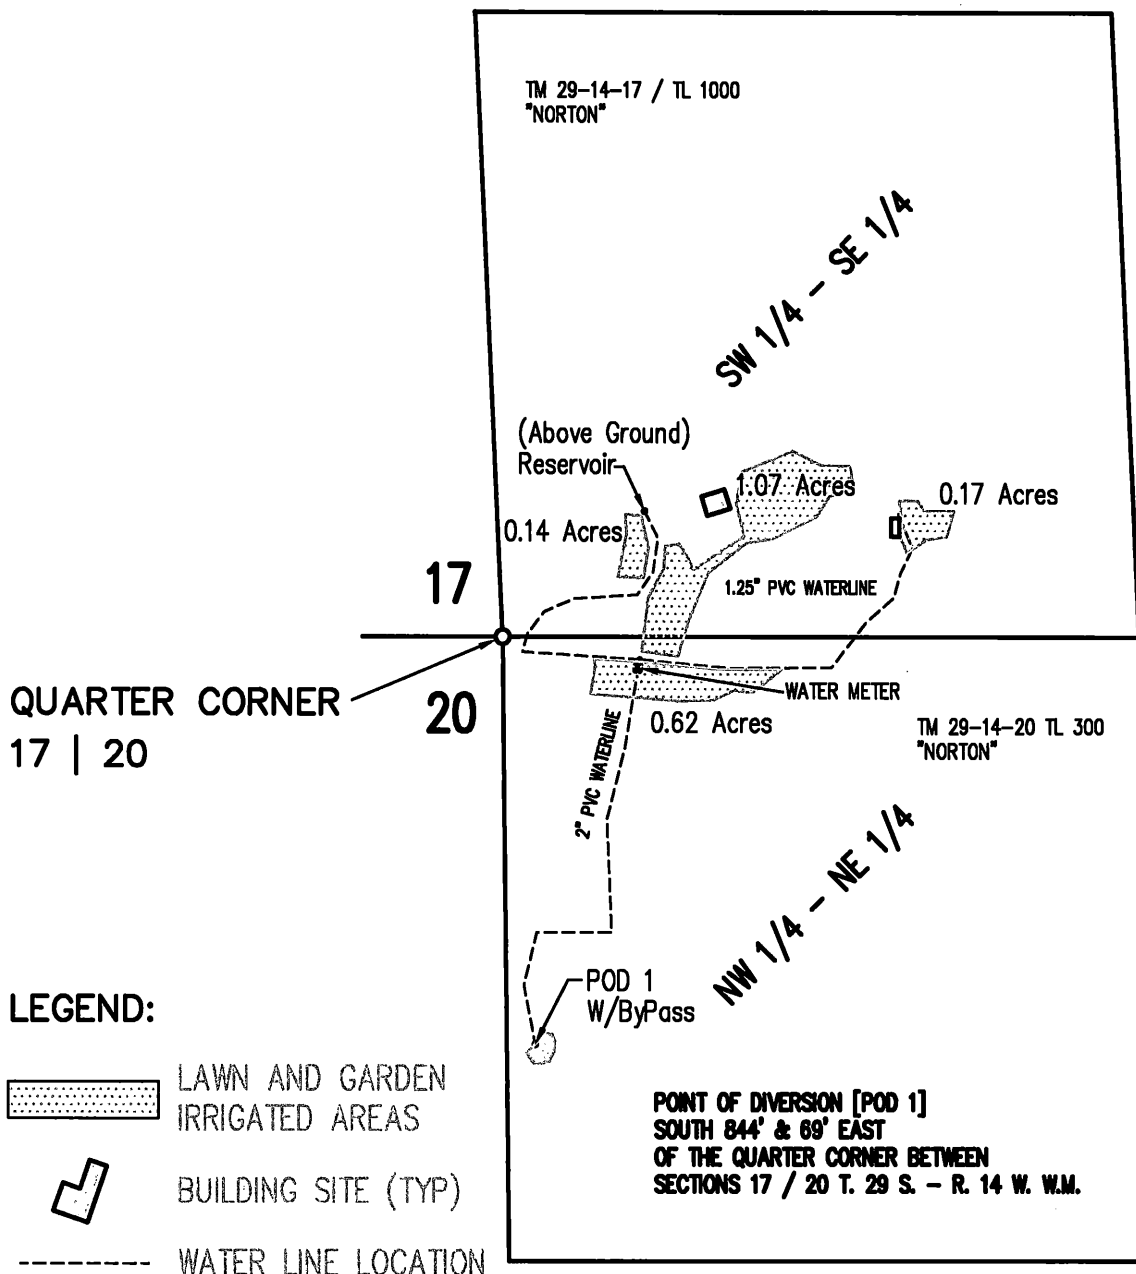


RECEIVED BY OWRD

SEP 08 2015

SALEM, OR

FINAL PROOF SURVEY

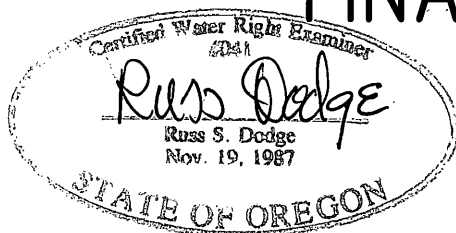

APPLICATION NO R-84956
PERMIT NO. R-13292
JULY 20, 2015

NOTE: THIS MAP WAS PREPARED FOR THE PURPOSE OF IDENTIFYING THE LOCATION OF A WATER RIGHT ONLY AND IS NOT INTENDED TO PROVIDE LEGAL DIMENSIONS OR LOCATION OF PROPERTY OWNERSHIP LINES.