



# SECTIONS 17 & 20

## T. 29 S., R. 14 W., W.M.

### COOS COUNTY, OREGON

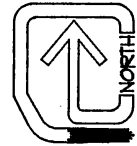

SCALE: 1" = 400'

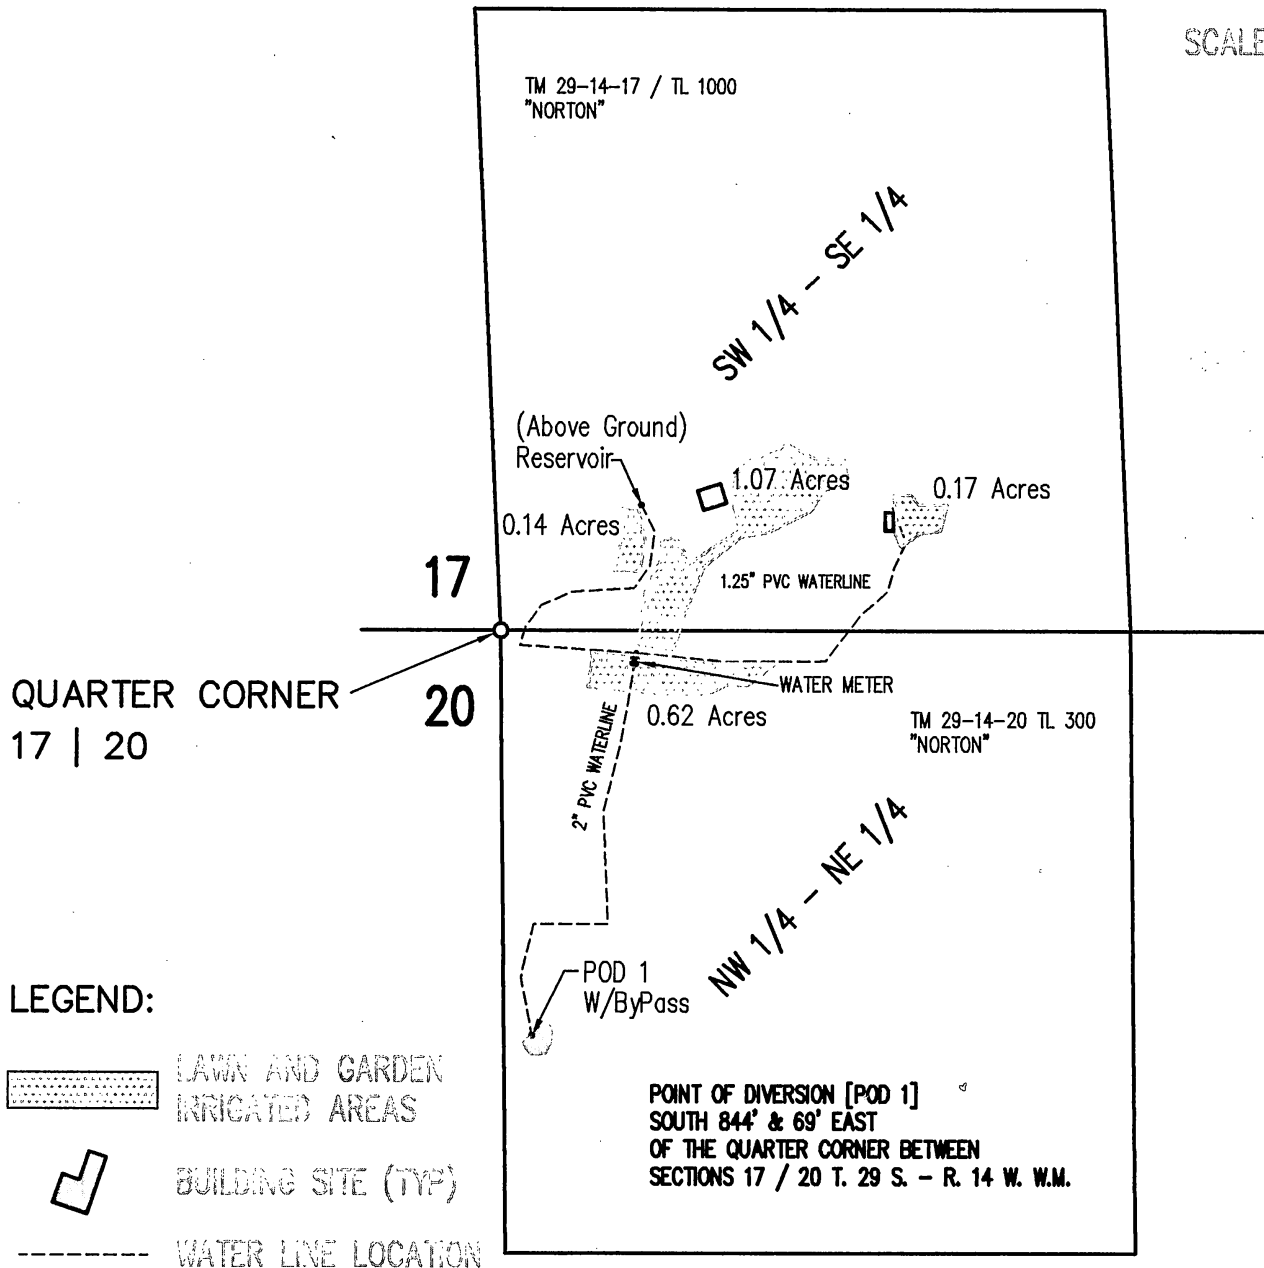

## FINAL PROOF SURVEY

*Luon Dodge*

APPLICATION NO S-84955  
PERMIT NO. S-53794  
JULY 20, 2015

NOTE: THIS MAP WAS PREPARED FOR  
THE PURPOSE OF IDENTIFYING THE  
LOCATION OF A WATER RIGHT ONLY  
AND IS NOT INTENDED TO PROVIDE  
LEGAL DIMENSIONS OR LOCATION OF  
PROPERTY OWNERSHIP LINES.