



T.3S. R.3W. Sec. 27 & 34, W.M.

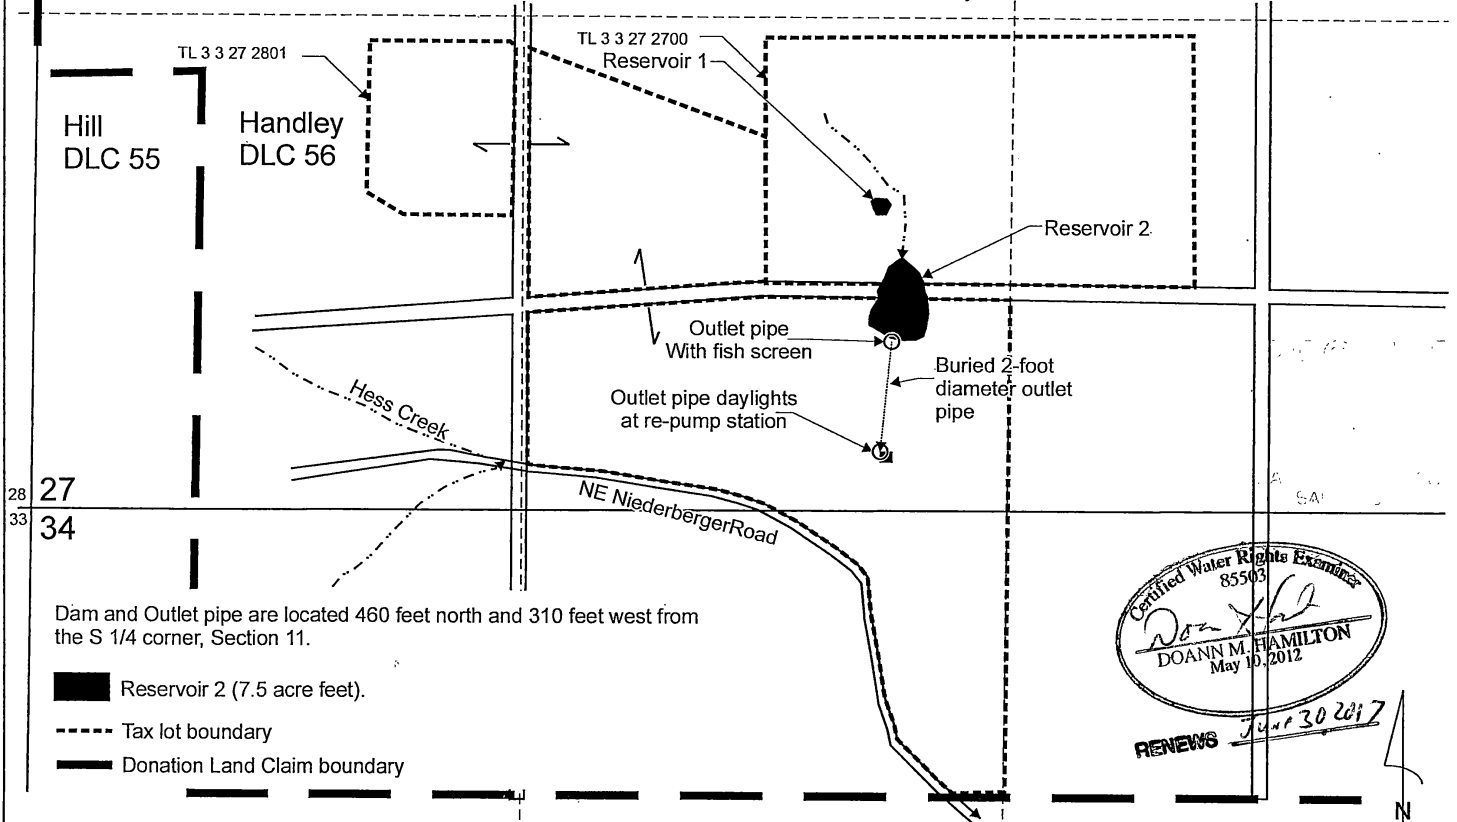

Dam and Outlet pipe are located 460 feet north and 310 feet west from the S 1/4 corner, Section 11.


- Reservoir 2 (7.5 acre feet).
- Tax lot boundary
- Donation Land Claim boundary

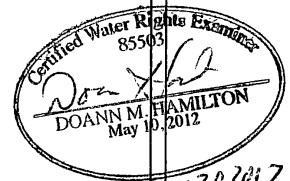

RENEWS June 30 2017

This map was prepared for the purpose of identifying the location of a water right only and is not intended to provide legal dimensions or location of property ownership lines.

Scale: 1" = 400'

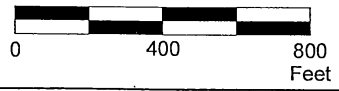

Pacific Hydro-Geology Inc.

08/2015

Claim of Beneficial Use Map
Application R-83596, Permit R-12487

Archery Summit Winery
T.3S. R.3W. Sec. 27 & 34, W.M.