



T.4S. R.1W. Section. 2, W.M.

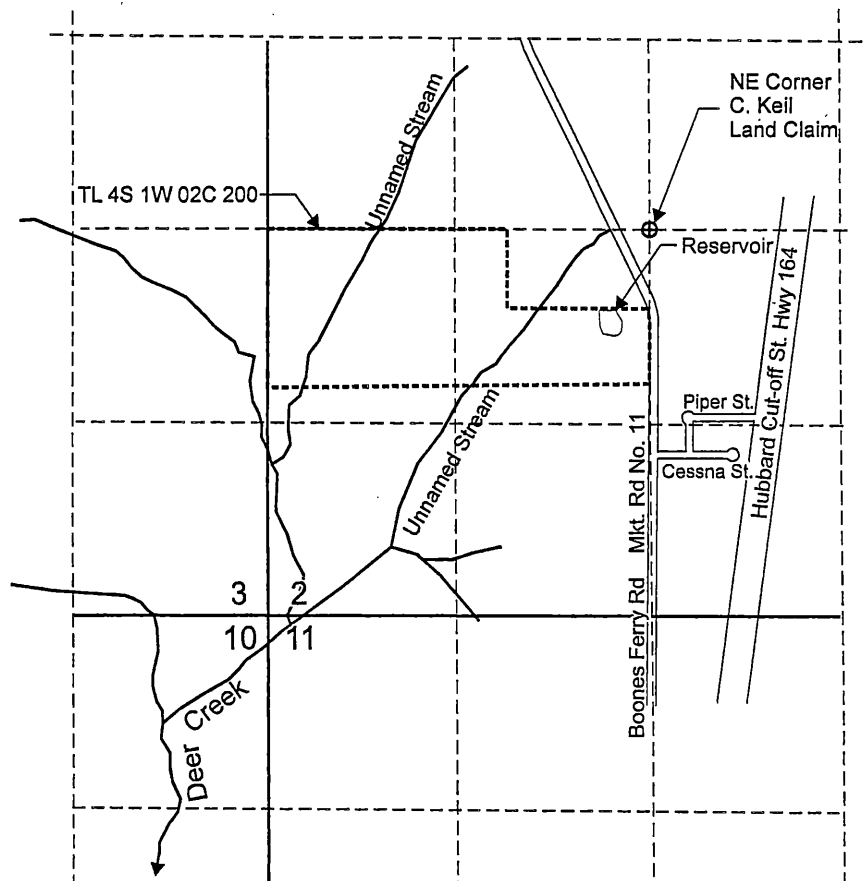

Pond is located 650 feet south and 250 feet west from the NE corner of C. Kiel Land Claim from the center of the pond

----- Tax Lot Boundary

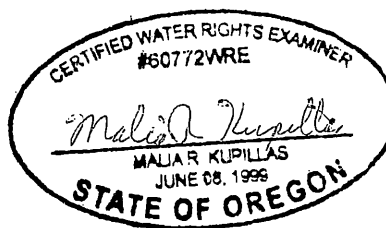

EXPIRATION DATE 6/30/2017

WATER RIGHTS EXAMINER
MALIA R. KUPILLAS

Scale: 1" = 1,320'



0 1,320
Feet

This map was prepared for the purpose of identifying the location of a water right only and is not intended to provide legal dimensions or location of property ownership lines.



Claim of Beneficial Use Map

Application R-84863; Permit R-13179

Pacific Hydro-Geology Inc.

Crown Landscaping

Bgp-10/2012

T.4S. R.1W., Section 2 Tax Lot 200