


T 2 S R 38 E

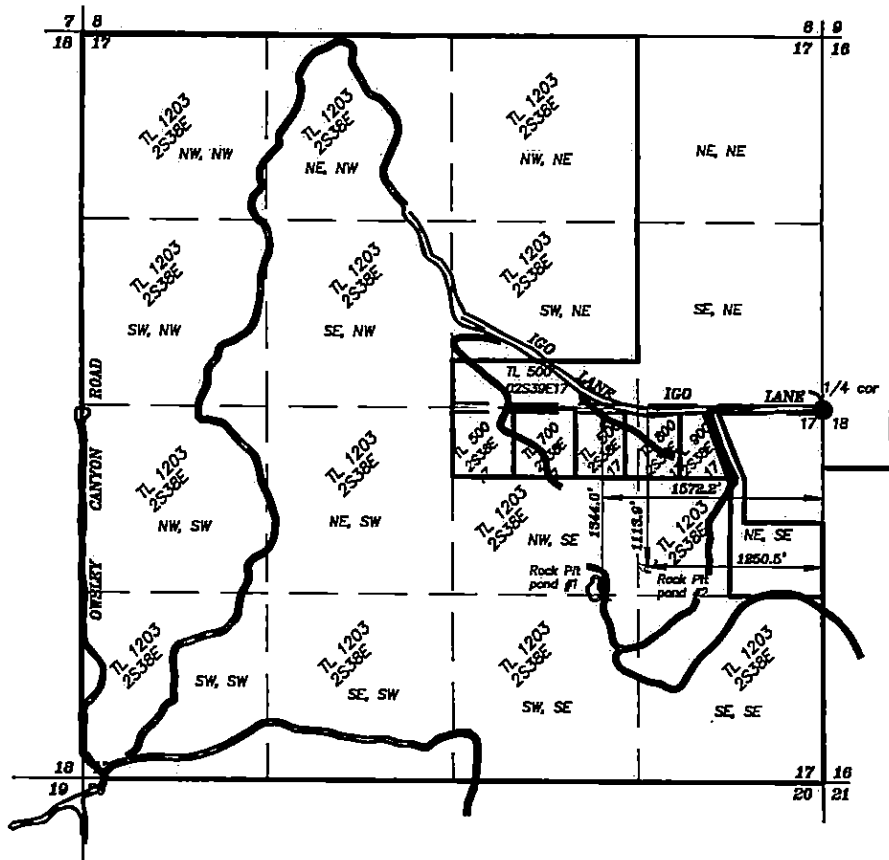


SCALE: 1"=1320'

SCALE: 1"=1320'

POND # 1 Latitude: 45°23'15.43093"N
Longitude: 118°04'55.91313"W

- Found monumented corner at the West 1/4 corner of Section 17, 2S R38E, WM

POND # 1 Latitude: 45°25'17.70251"N
Longitude: 118°04'51.40541"W

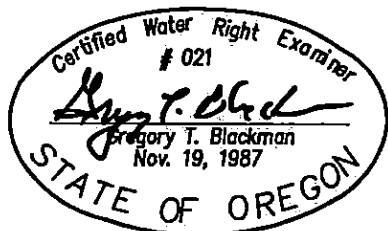

September 21, 2015
**CLAIM OF BENEFICIAL USE MAP
FOR RESERVOIRS # 1 AND #2
UNDER PERMITS R-12848
AND PERMIT R-12849
FOR
UNION COUNTY MOUNT EMILY
RECREATION AREA**

RECEIVED BY OWRD

NOV 12 2015

SALEM, OR

BY
GREG BLACKMAN WATER RIGHTS
126 RIDGE DRIVE
LAGRANDE, OREGON 97850
Application No. R-84212 & R-84213
Permit Number R-12848 & R-12849

NOTE: The preparation of this map was for the purpose of identifying the location of the proposed water right and has no intent to provide dimensions or location of property ownership lines. Location information shown hereon was furnished by the applicant.