


T26S, R30E, W.M.
Harney County, Oregon

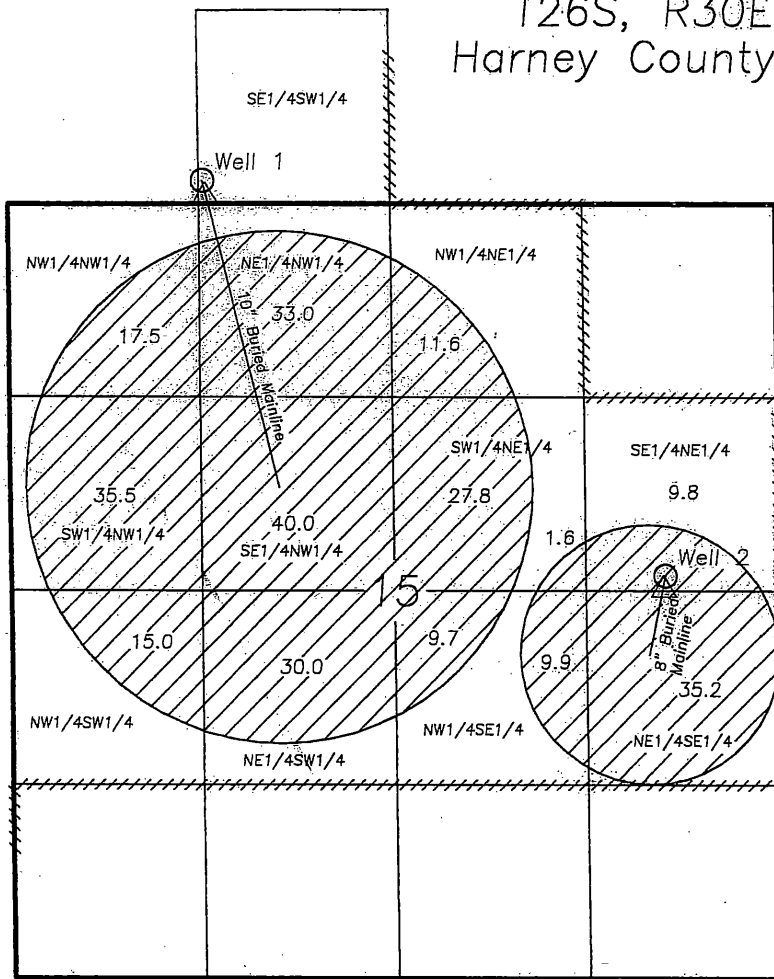


SCALE 1"=1320'

Well 1 is 5316'N and 4196'E of the SW corner of Section 16.
Well 2 is 2621'N and 9878'E of the SW corner of Section 16.

Well 1 coordinates more accurately described are
5316' N and 6728' E of SW Cor of Sec 16
GCWRD


LEGEND Confirmed by CWRE 51324 5/4/2019

 Irrigation Place of Use
Permit G-16257

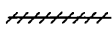 Property Boundary

Tax Map T26S-R30NE

Tax Lot No. 2300

 Flow Meter

FINAL PROOF SURVEY

For

Joseph R. Buerman

April 27, 2011

Application G-16599
Permit G-16257

Map Prepared by

Cornerstone Surveying, Inc

P.O. BOX 33

JOHN DAY, OR. 97845

(541)575-1813

cornerstonesurvey@centurytel.net

NOTE: The preparation of this map was for the purpose of identifying the location of the proposed water right and has no intent to provide dimensions or location of property ownership lines.

