


953



SCALE 1" = 400'

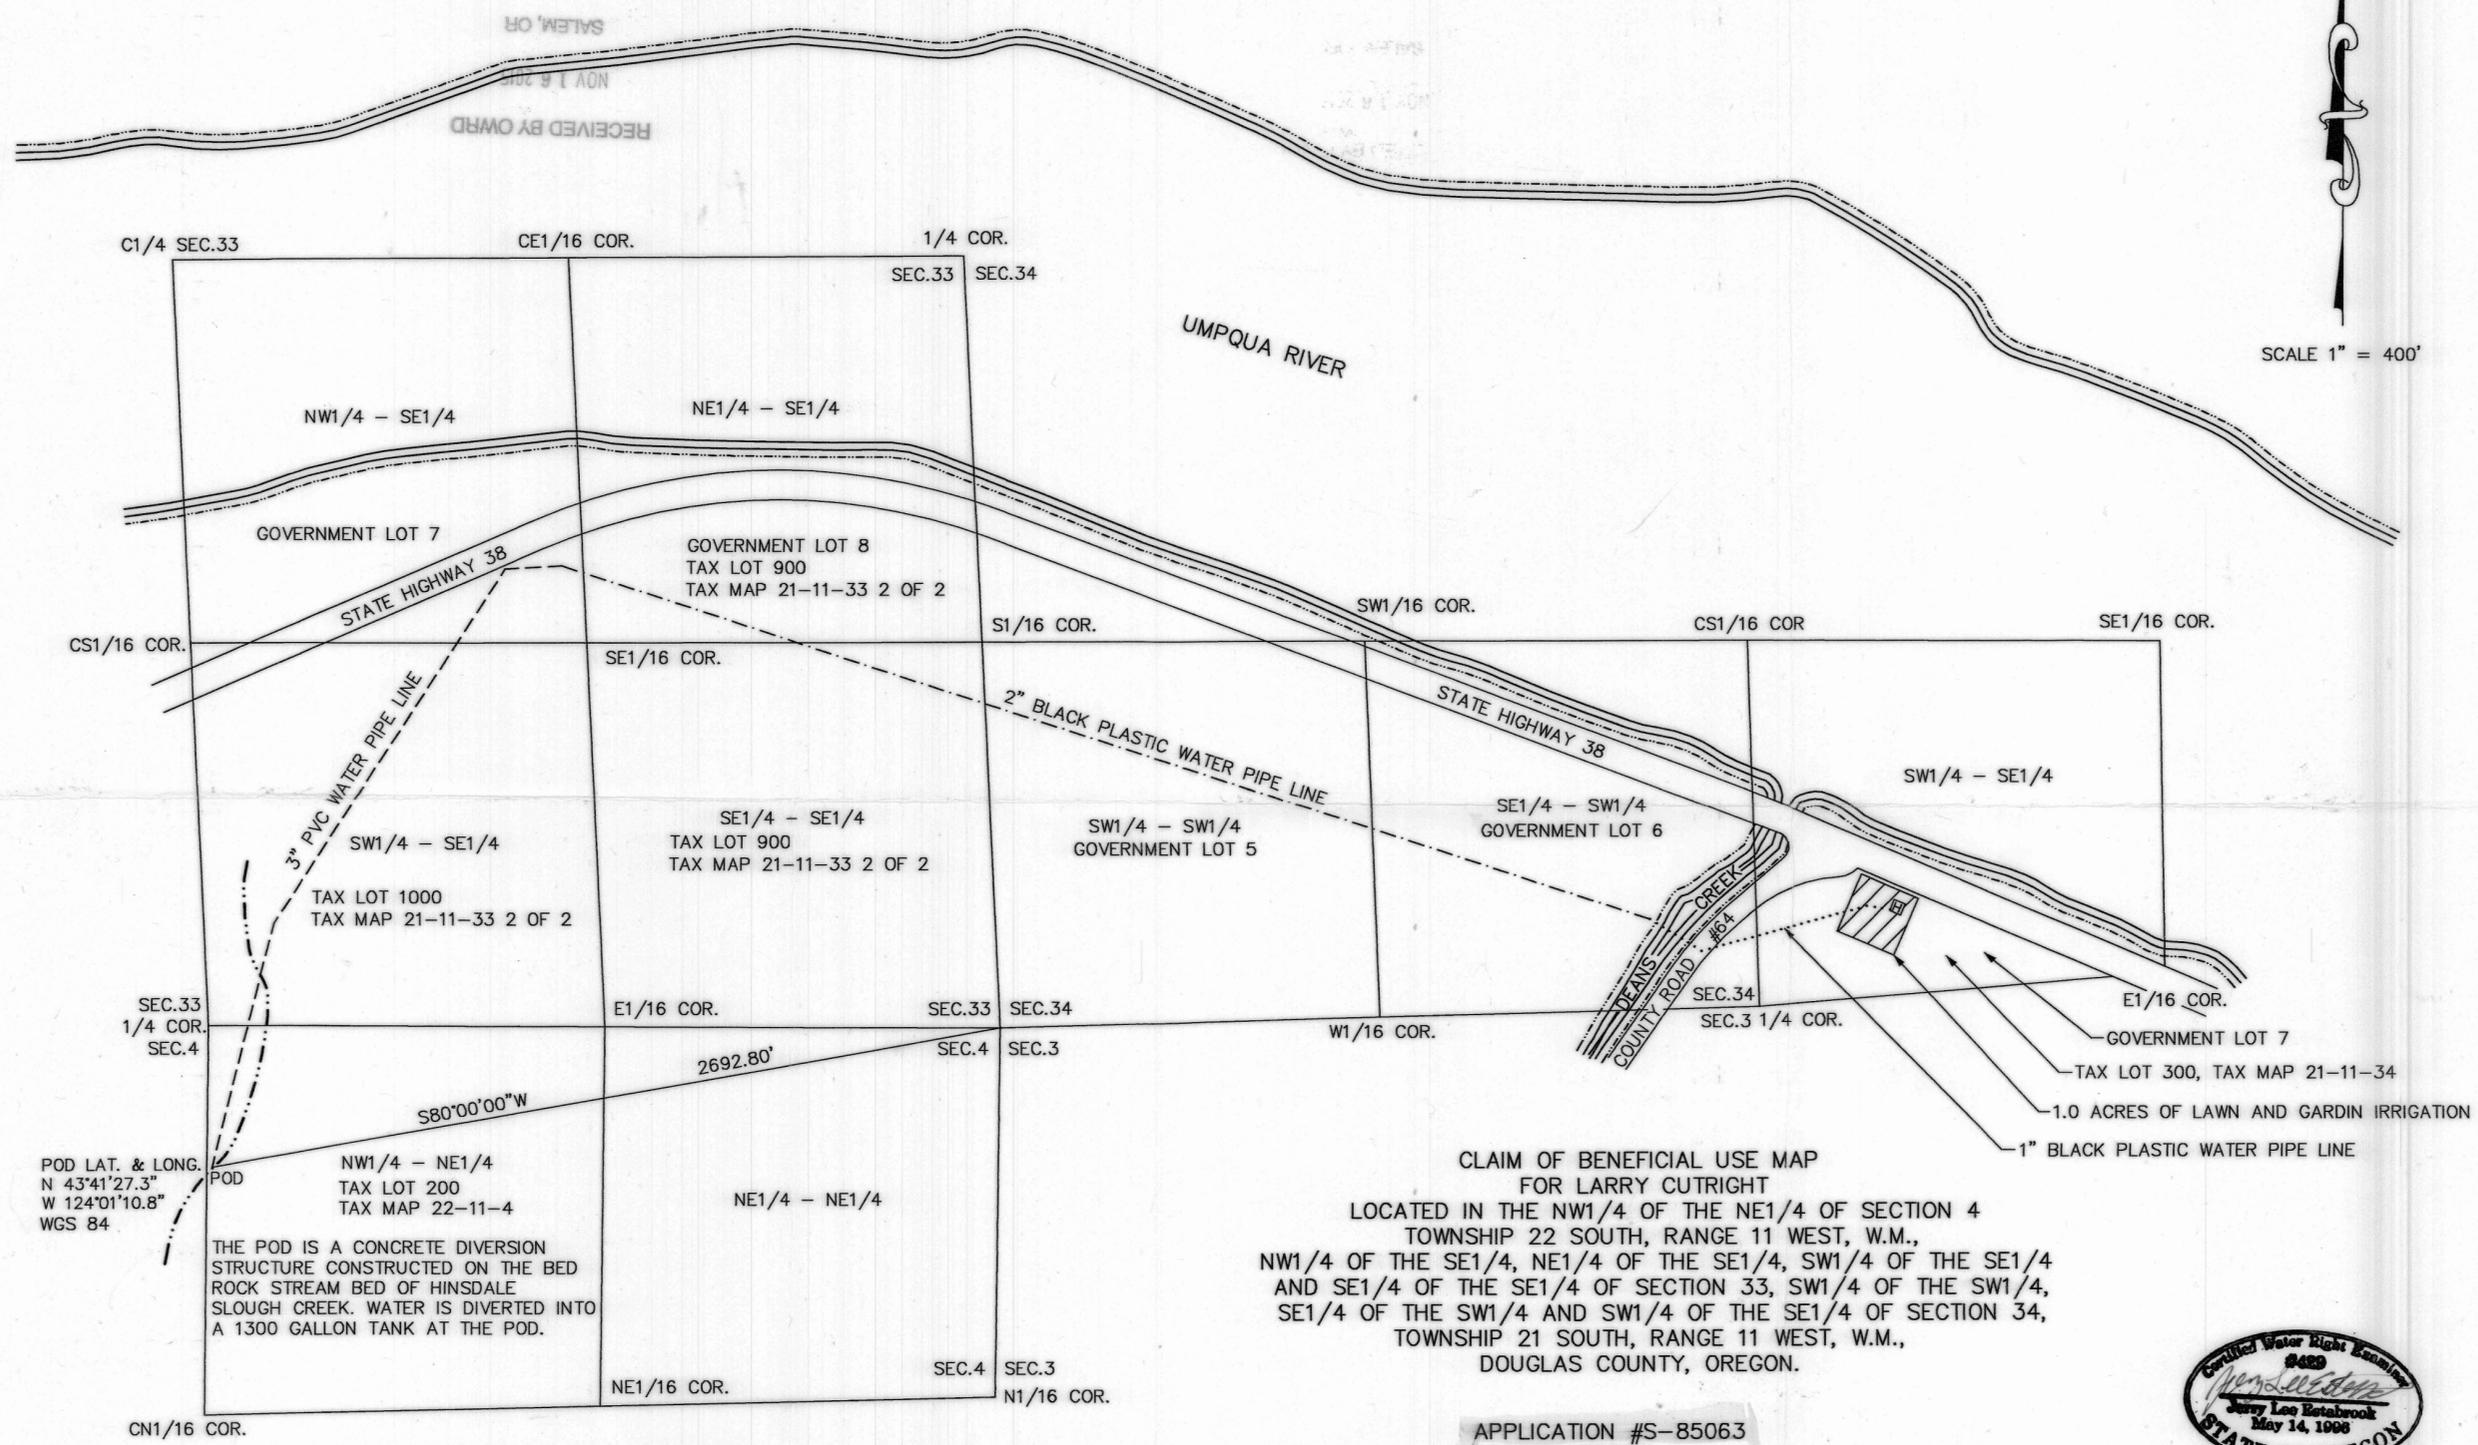


POD LAT. & LONG.  
 N 43°41'27.3"  
 W 124°01'10.8"  
 WGS 84

THE POD IS A CONCRETE DIVERSION  
 STRUCTURE CONSTRUCTED ON THE BED  
 ROCK STREAM BED OF HINSDALE  
 SLOUGH CREEK. WATER IS DIVERTED INTO  
 A 1300 GALLON TANK AT THE POD.

CLAIM OF BENEFICIAL USE MAP  
 FOR LARRY CUTRIGHT  
 LOCATED IN THE NW1/4 OF THE NE1/4 OF SECTION 4  
 TOWNSHIP 22 SOUTH, RANGE 11 WEST, W.M.,  
 NW1/4 OF THE SE1/4, NE1/4 OF THE SE1/4, SW1/4 OF THE SE1/4  
 AND SE1/4 OF THE SE1/4 OF SECTION 33, SW1/4 OF THE SW1/4,  
 SE1/4 OF THE SW1/4 AND SW1/4 OF THE SE1/4 OF SECTION 34,  
 TOWNSHIP 21 SOUTH, RANGE 11 WEST, W.M.,  
 DOUGLAS COUNTY, OREGON.

APPLICATION #S-85063  
 PERMIT #53833

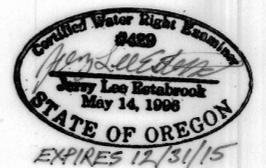

COBU MAP # 953

EXAMINERS DISCLAIMER STATEMENT:  
 THE PREPARATION OF THIS MAP WAS FOR THE PURPOSE OF  
 IDENTIFYING THE LOCATION OF WATER RIGHT ONLY AND HAS  
 NO INTENT TO PROVIDE DIMENSIONS OR LOCATION OF  
 PROPERTY OWNERSHIP LINES.

- LEGEND:
- HOUSE
  - POINT OF DIVERSION
  - 3 INCH PVC WATER PIPE LINE
  - 2 INCH BLACK PLASTIC WATER PIPE LINE
  - 1 INCH BLACK PLASTIC WATER PIPE LINE
  - HINSDALE SLOUGH CREEK

MAP PREPARED BY: ESTABROOK LAND SURVEYING INC.  
 PO BOX 574  
 LAKESIDE, OR 97449

DRAWN BY: JLE	DATE: 11/3/15
CHECKED BY: TJE	DRAWING NO.: CUTRIGHT
JOB NO.: 2015-67	SHEET 1 OF 1