

CLAIM OF BENEFICIAL USE MAP

FOR: SUTHERLIN WATER CONTROL DISTRICT

BY: NATHAN R. REED, P.E., CWRE

T25S, R5W, W.M. SECTION 14, DLC NO. 41


APPLICATION NO. S-87826

PERMIT NO. S-54794



SCALE: 1" = 400'

DATE SURVEYED: MAY 11, 2015

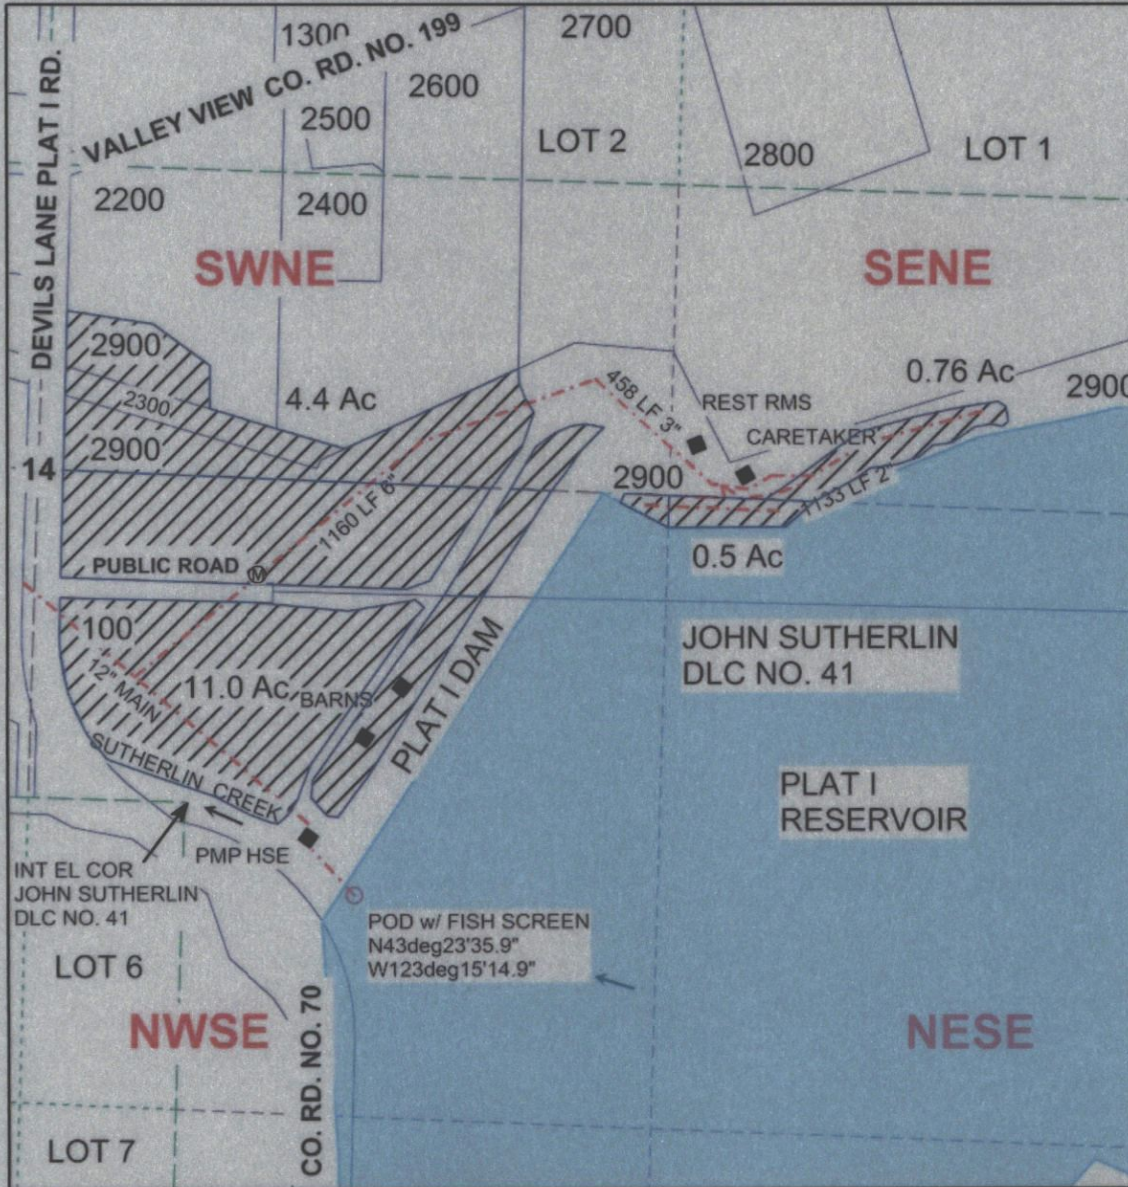


POD IS 800 FEET SOUTH AND 580 FEET EAST FROM CENTER COR SEC 14 AS PROJECTED WITHIN JOHN SUTHERLIN DLC 41.

MAP PREPARED FOR:
SUTHERLIN WATER CONTROL DIST.
495 N. STATE ST.
SUTHERLIN, OR 97479

RECEIVED BY OWRD

JUL 02 2015

SALEM, OR

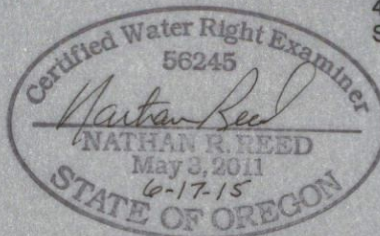

Expires Dec. 31, 2016

THE PURPOSE OF THIS MAP IS TO IDENTIFY THE LOCATION OF THE WATER RIGHT. IT IS NOT INTENDED TO PROVIDE INFORMATION RELATIVE TO THE LOCATION OF PROPERTY OWNERSHIP BOUNDARY LINES.

MAP PREPARED BY:
NATHAN R. REED, P.E., CWRE
1113 SE CASS AV
ROSEBURG, OR 97470