

T. 3N. R2W., W.M.


Michael Vern Smith

NW 1/4 NW 1/4 SECTION 25
MULTNOMAH COUNTY
20300 NW WATSON ROAD
SCAPPOOSE, OR 97056

P.O.U. - PLACE OF
IRRIGATION USE
BY ACRES BY 1/4 - 1/4

SECTION 25

TAXLOT 1500
NW 1/4 NW 1/4 - 5.72 AC
TAXLOT 1600
NW 1/4 NW 1/4 - 4.46 AC
TOTAL SEC 25 = 10.18 AC

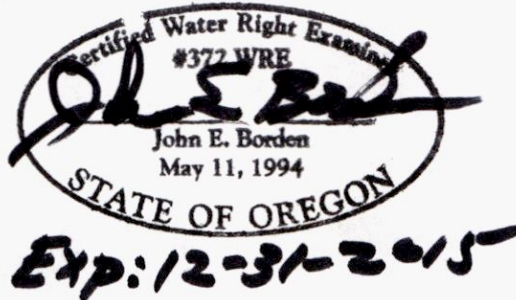

SCALE:
1" = 400'

LEGEND

- USGS GRID
- TAXLOT LINE
- ROADWAY
- STRUCTURE
- WATER
- PIPING
- P.O.U.
- WELL (P.O.A.)
- SECTION CORNER
- 1/4 OR 1/16 CORNER

Survey

AND CLAIM OF BENEFICIAL USE
UNDER

APPLICATION No. G-13525,
PERMIT No. G-12331

IN THE NAME OF
MICHAEL VERN SMITH

FOR

AGRICULTURAL USE AND IRRIGATION
FROM TWO WELLS IN THE JOY CREEK
BASIN,


SURVEYED NOVEMBER 5, 2013,
THEN AUGUST 22, 2015.

BY JOHN E. BORDEN, CWRE

RECEIVED

OCT 13 2015

WATER RESOURCES DEPT
SALEM, OREGON

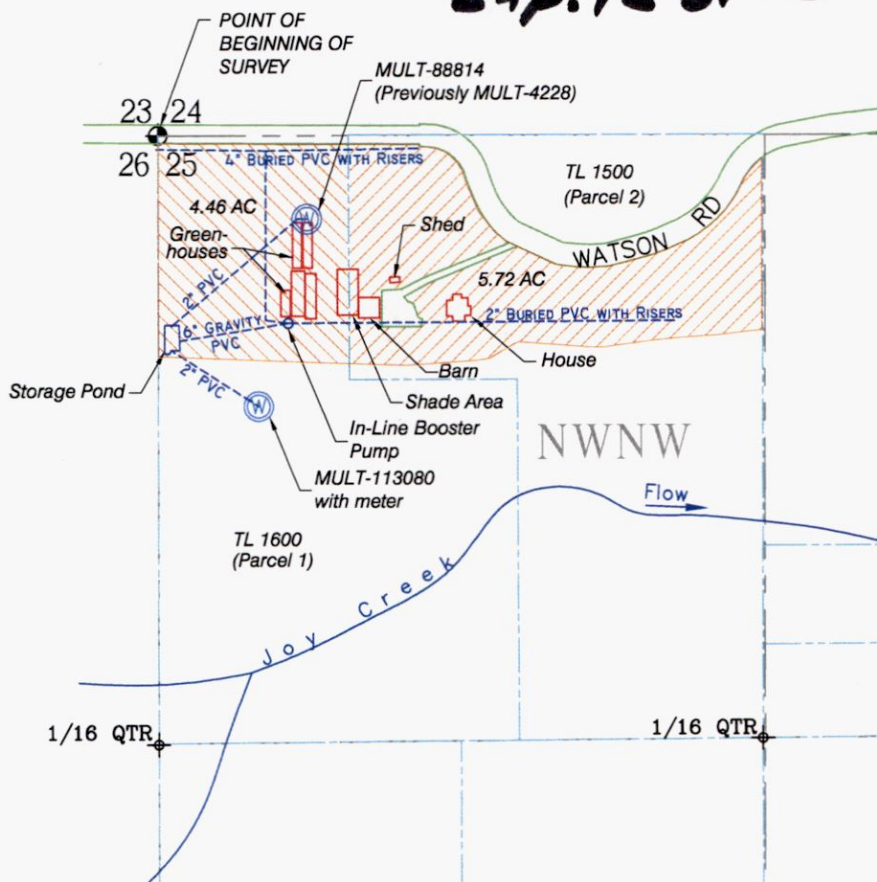

PREPARATION OF THIS MAP IS
FOR THE PURPOSE OF
IDENTIFYING THE LOCATION
OF THE WATER RIGHT ONLY.
THERE IS NO INTENT TO
PROVIDE DIMENSIONS OR
LOCATION OF PROPERTY
OWNERSHIP LINES.

NOTES:

MULT-88814 IS LOCATED 182 FT SOUTH AND
324 FT EAST OF THE NW CORNER OF SECTION 25.
METER HAS BEEN REMOVED. WELL MAY OR MAY NOT BE
RETURNED TO USE.

MULT-113080 IS LOCATED 589 FT SOUTH AND
218 FT EAST OF THE NW CORNER OF SECTION 25.

JOHN BORDEN CONSULTING

5597 RIVER STREET
WEST LINN, OR. 97068
503-723-4257

Joy Creek Nursery Water Right

FILE PATH & NAME: D:\JOY_CREEK_NURSERY_092015.DWG