


EXHIBIT B

T19S, R34E, W.M.
Harney County, Oregon

RECEIVED

AUG 08 2019

OWRD

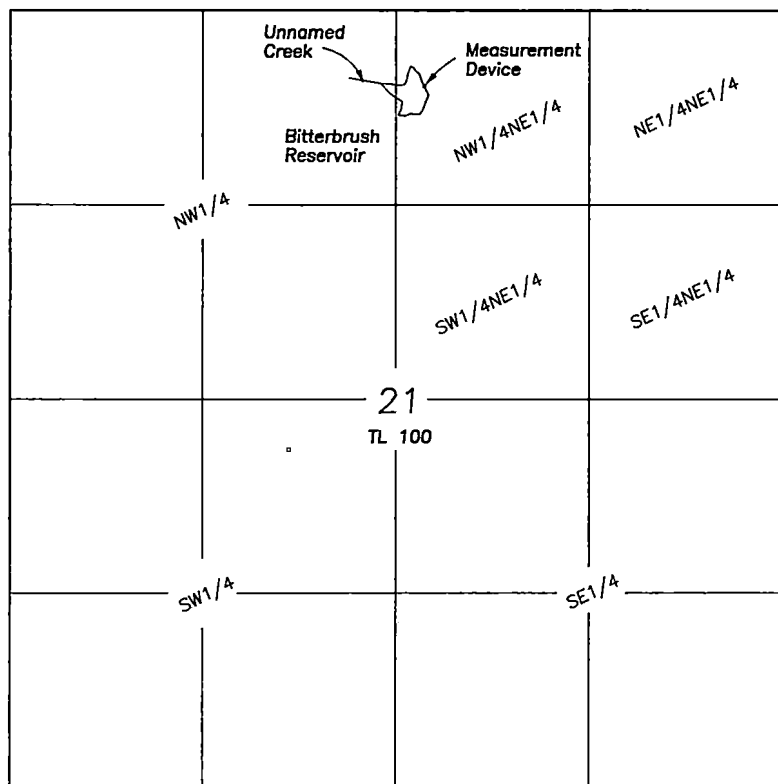

SCALE 1"=1320'

Outlet is located 510' South & 2420' West of the
NE corner of Section 21.

Measuring device is located 20' west of the Outlet.

FINAL PROOF SURVEY
CLAIM OF BENEFICIAL USE
BITTERBRUSH RESERVOIR

For

Bureau of Land Management

June 1, 2019

LEGEND

Application No. R-46192
Permit No. R-7891
Priority 7/7/1969

A portion of Tax Lot
19-34 TL100

NOTE: Tax Lot 300 is owned by the BLM
and is more that 21,000 acres.
No boundaries of the tax lot
can be shown.

NOTE: The preparation of this map
was for the purpose of identifying
the location of the proposed water
right and has no intent to provide
dimensions or location of property
ownership lines.

Prepared by
Cornerstone Surveying, Inc

P.O. BOX 33
JOHN DAY, OR. 97845
(541)575-1813
jwsurvey55@gmail.com

