

LEGEND

- Transfer From
- Transfer To

Scale" 1" = 200'

NEW DIVERSION POINT,
METER AND FISH SCREEN
WEST 1220' AND
SOUTH 24' FROM
NORTH 1/4 CORNER
SECTION 8


- ① ORIGINAL DIVERSION POINT
CERTIFICATE NO. 36796,
230' SOUTH AND 1080' WEST OF
NORTH 1/4 CORNER SECTION 8,
TOWNSHIP 6 SOUTH, RANGE 7 WEST,
OF THE WILLAMETTE MERIDIAN
- ② ORIGINAL DIVERSION POINT
CERTIFICATE NO. 50623,
230' SOUTH AND 1060' WEST OF
NORTH 1/4 CORNER SECTION 8,
TOWNSHIP 6 SOUTH, RANGE 7 WEST,
OF THE WILLAMETTE MERIDIAN

NOTES:

- 1. Diversion point location and location of area to be irrigated provided by owner.
- 2. This map was prepared for the purposes of identifying the location of the water right only and is not intended to provide legal dimensions or locations of property ownership lines.

Prepared For:

The Confederated Tribes of
the Grand Ronde Community
9615 Grand Ronde Road
Grand Ronde, Oregon 97347
Phone: (503) 879-2404
Fax: (503) 879-1372

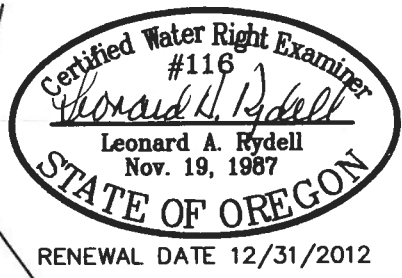

W.O. No. 0612
26 September 2012
DWG: 0612-Final Proof.DWG

CERTIFICATES 36796 AND 50623
TRANSFER T-10569 FINAL PROOF SURVEY
Located in Government Lot 6 in the NE 1/4 of the NW 1/4 Section 8 and
Government Lots 27 and 28 in the SE 1/4 of the SW 1/4 Section 5,
Township 6 South, Range 7 West of the Willamette Meridian
Polk County, Oregon

LEONARD A. RYDELL, P.E., P.L.S.
601 Pinehurst Drive, Newberg, Oregon 97132
(503) 538-5700
Mobile (503) 781-4138
FAX (503) 538-9167
larydell@teleport.com
Consulting Civil Engineer - Land Surveyor - W.R.E.

COBU MAP # 723 folder V