


FINAL PROOF MAP

TO TRANSFER PLACE OF USE
PER T-6657
FOR ANNE DESANTIS

TOWNSHIP 7 SOUTH, RANGE 1 EAST, SECTION 21 W.M.
TAX LOT: 100
MARION COUNTY, OREGON

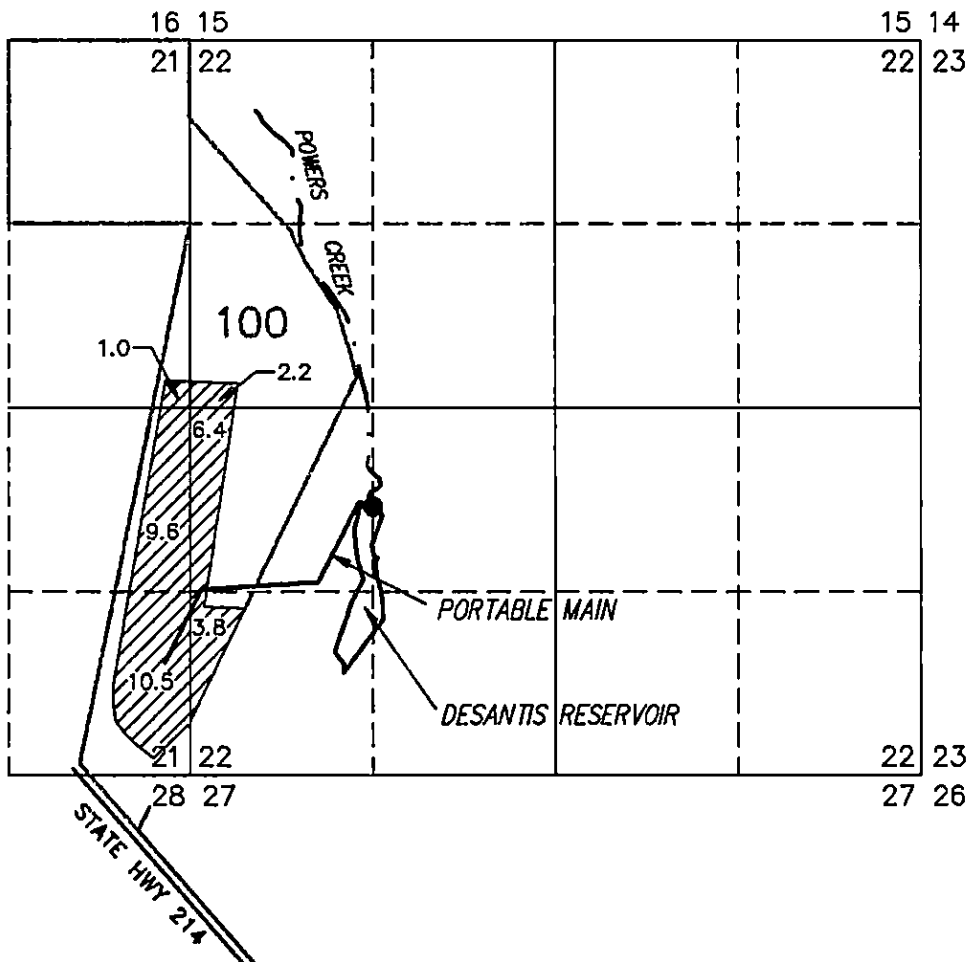

THIS MAP IS FOR THE PURPOSE OF
LOCATING A WATER RIGHT ONLY AND
HAS NO INTENT TO PROVIDE LEGAL
DIMENSIONS OR THE LOCATION OF
PROPERTY LINES




RECEIVED

JAN 05 2011

WATER RESOURCES DEPT
SALEM, OREGON

- POD DESANTIS RESERVOIR
SPILLWAY OF RESERVOIR FROM
PERMIT: R-5849 710 FEET SOUTH
AND 1320 FEET WEST FROM THE
CENTER CORNER OF SECTION 22

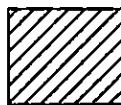

33.5 ACRES PRIMARY
IRRIGATION FROM C #40131 PER
T-6657, AS SHOWN



RENEWAL DATE: 12/31/2012

PREPARED FOR:

6

ANNE DESANTIS
9912 114TH ST NE
MT. ANGEL, OR 97362

PREPARED BY:



ALL POINTS ENGINEERING AND SURVEYING, INC.
P.O. BOX 767 (CRR) TERREBONNE, OR 97760
(541) 548-5833
www.APEandS.com