


T. 28 S., R. 6 W., W.M.

RECEIVED

APR 20 1992

WATER RESOURCES DEPT.
SALEM, OREGON

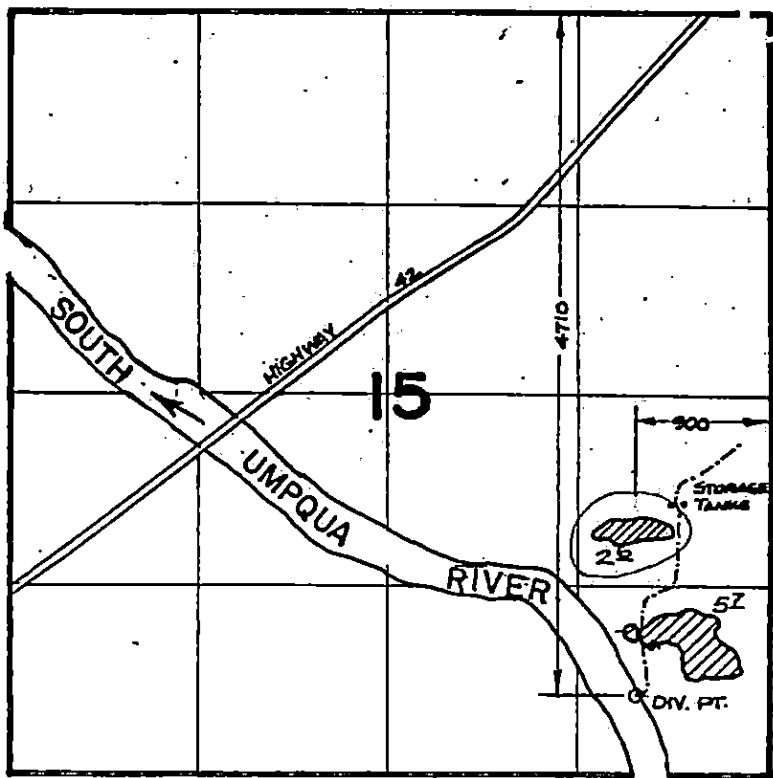

SCALE: 4" = 1 MILE

Application No. 64848. Permit No. 47636.....
IN NAME OF

.....JOHN HANNAH.....

Surveyed MAY 6,..... 1987., by J.M. SCHMORDE.