

# TOWNSHIP 22 SOUTH RANGE 10 EAST, W.M.

NE 1/4 SECTION 11

WELL NO. 1 LOCATED  
NORTH 1897.13' & WEST 300.4'  
FROM SE CORNER SECTION 11

WELL NO. 2 LOCATED  
NORTH 2506.61' & EAST 699.63'  
FROM SE CORNER SECTION 11

US HIGHWAY NO 97

1/4 COR. 11+12

WELL NO. 2

NW 1/4 - SE 1/4

NE 1/4 - SE 1/4

2150 AC

2139 AC

WELL NO. 1

16' Supply Line

POD. 3' PVC

LAGOONS

LaPINE INDUSTRIAL SITE

CENTER PIVOT

IRRIGATION SPRAY LINE (ROTATING)

SW 1/4 SECTION 12

2193 AC

2196 AC

TM 22 10 - TL 101

SW 1/4 - SE 1/4

SE 1/4 - SE 1/4

TL 100

MONITORING WELL

BURLINGTON NORTHERN RAILROAD

REED ROAD

SECTION CORNER

1/4 COR. 11+14


## FINAL PROOF SURVEY

UNDER

APPL NO. G 12500 PER NO. 12545

SEPTEMBER 5, 2003

SCALE: 1" = 500'

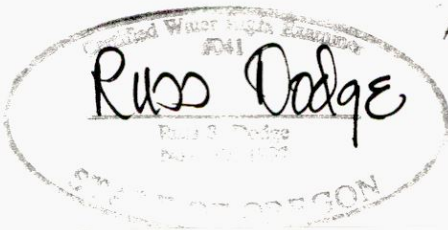

RECEIVED

DEC 05 2003

THIS MAP WAS PREPARED FOR THE PURPOSE OF IDENTIFYING THE LOCATION OF A WATER RIGHT ONLY AND IS NOT INTENDED TO PROVIDE LEGAL DIMENSIONS OR LOCATION OF PROPERTY OWNERSHIP LINES.

The map should only reflect 18.75 acres for each 1/4 1/4.

WRD/CNH 6/17/2019

WATER RESOURCES DEPT  
SALEM, OREGON