







 




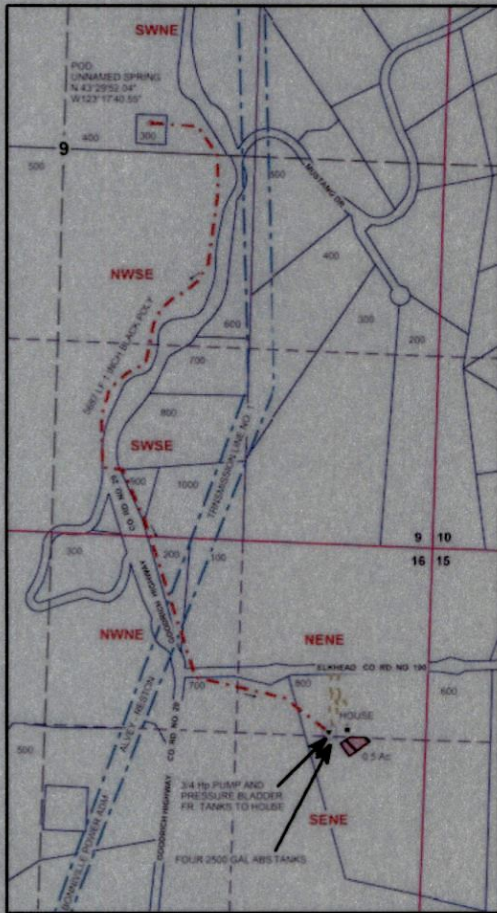


 

**CLAIM of BENEFICIAL USE MAP**  
**FOR: GREGORY M. CRAMER**  
**BY: NATHAN R. REED, CWRE**  
**T24S, R5W, W.M. SECTION 16**  
**APPLICATION NO. S-84193**  
**PERMIT NO. S-53653**

Scale: 1" = 1320'

DATE SURVEYED: December 1, 2015

**Legend**




-  POD
-  Pipeline
-  Flow Arrow
-  Water Tank
-  Pump
-  Irrigation
-  Driveway
-  BPA Easement
-  Section
-  Structure
-  Quarter
-  Sixteenth
-  Parcels

RECEIVED BY OWRD

DEC 11 2015

SALEM, OR

POD IS LOCATED 2030 FEET WEST AND 2860 FEET NORTH OF THE SE CORNER, SECTION 9.

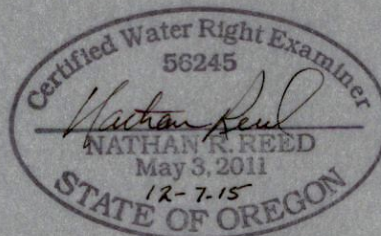

Expires Dec. 31, 2016

MAP PREPARED FOR:  
 GREGORY M. CRAMER  
 381 HOGAN ROAD  
 OAKLAND, OR 97462

THE PURPOSE OF THIS MAP IS TO IDENTIFY THE LOCATION OF THE WATER RIGHT. IT IS NOT INTENDED TO PROVIDE INFORMATION RELATIVE TO THE LOCATION OF PROPERTY OWNERSHIP BOUNDARY LINES.

MAP PREPARED BY:  
 NATHAN R. REED, P.E., CWRE  
 1113 SE CASS AV  
 ROSEBURG, OR 97470