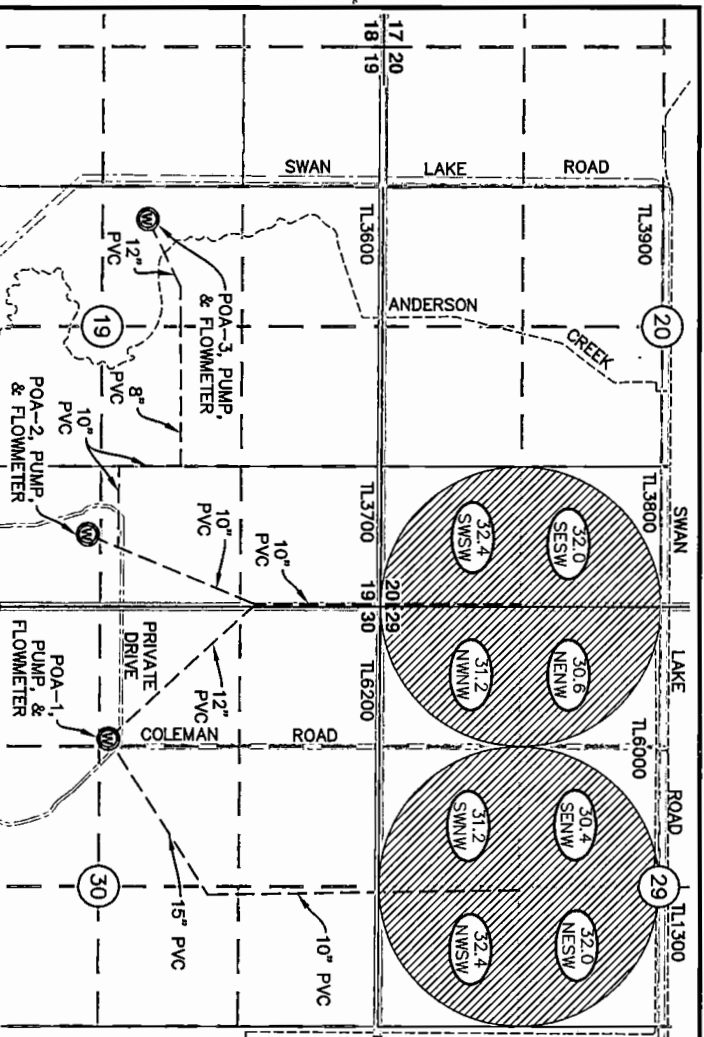


LEGEND

- SECTION LINE
- 1/4 1/4 LINE
- TAX LOT LINE
- CREEK/DITCH
- BURIED PIPE
- ROAD
- TL3800
- TAX LOT NUMBER
- POA (WELL)
- 17 20
- 18 19
- SECTION CORNER
- SECTION CENTER
- IRRIGATED UNDER TRANSFER T-12244
- IRRIGATED ACRES
- 1/4 1/4 SECTION
- 32.0
- SWSE

WELL TIES

POA-1: 1250'± SOUTH & 2560'± WEST FROM THE NORTHEAST CORNER OF SECTION 30.
 POA-2: 670'± NORTH & 2780'± WEST FROM THE SOUTHERN CORNER OF SECTION 19.
 POA-3: 1630'± SOUTH & 2220'± WEST FROM THE NORTHEAST CORNER OF SECTION 19.

NOTES

1. THE PURPOSE OF THIS MAP IS TO IDENTIFY THE LOCATION OF THE WATER RIGHT AND WELLS ONLY, AND IS NOT INTENDED TO PROVIDE DIMENSIONS OR LOCATION OF PROPERTY LINES.
2. FOR TAX LOT INFORMATION, SEE TAX MAPS INCLUDED WITH THIS APPLICATION.
3. DATE OF PRIORITY FOR TRANSFER FINAL ORDER T-12244 IS NOVEMBER 21, 2016.

ALE ADKINS

ENGINEERING & SURVEYING
 1435 ESPLANADE AVENUE, KLAMATH FALLS, OR 97601

o / 541.884.4666
 w / AdkinsEngineering.com

RECEIVED


FEB 21 2019

OWRD

CLAIM OF BENEFICIAL USE AND FINAL PROOF MAP

FOR

JOSEPH & SUSAN HARTER
 RIDE SECS. 19, 20, 29, & 30, WM
 KLAMATH COUNTY, OREGON
 TRANSFER T-12244

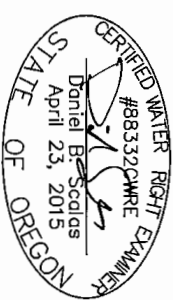

APPLICANT
[Signature]
 APPLICANT
[Signature]

RENEWAL 06/30/20