



COBU MAP# 1179

Certified Water Right Examiner
59859
Kaid E. McKay
KAID EDWARD MCKAY
MAY 21, 2010
STATE OF OREGON
EXPIRES : 12-31-2020

CLAIM OF BENEFICIAL USE MAP

APPLICATION S-72279 / PERMIT S-53459
IN THE SOUTHEAST QUARTER OF THE SOUTHWEST QUARTER
AND THE SOUTHWEST QUARTER OF THE SOUTHEAST QUARTER
SECTION 33, T6N, R10W, WILLAMETTE MERIDIAN
LOTS 1203, 1204, 1205, 1206, 1207 AND 1208 OF TAX MAP T6N R10W SECTION 33
CLATSOP COUNTY, OREGON
MARCH 13, 2019

FOR:
NORTH COAST LAND CONSERVANCY
P.O. BOX 67
SEASIDE, OREGON 97138

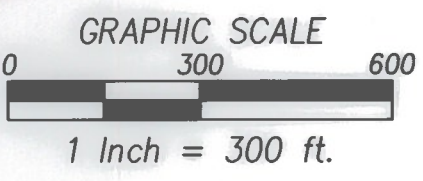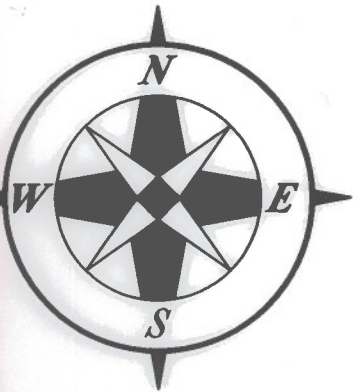

LEGEND

--- PROPERTY BOUNDARY
--- SECTIONAL LINE

COBU MAP# 1179

SEASONAL STREAM, AN
UN-NAMED TRIBUTARY OF
CIRCLE CREEK A TRIBUTARY
OF NECANICUM RIVER

T6N, R10W, W.M.
T5N, R10W, W.M.

POD #1
750' WEST, 170' NORTH
OF S 1/4 CORNER OF
SECTION 33

SEASONAL STREAM, AN
UN-NAMED TRIBUTARY OF
CIRCLE CREEK A TRIBUTARY
OF NECANICUM RIVER

APPROXIMATE LOCATION
OF WATER LINE

T.L. 1208
T.L. 1201
NOT A PART

T.L. 1205
T.L. 1204

HOUSE

BARN

HOSE BIB

T.L. 1206
HOUSE

SHOP

HOSE BIB
AND GARDEN

T.L. 1207
T.L. 1200
NOT A PART

6,000 GALLON
STORAGE TANK

SOUTH QUARTER
CORNER OF
SECTION 33

THIS MAP WAS PREPARED FOR THE PURPOSE OF IDENTIFYING THE
LOCATION OF A WATER RIGHT ONLY AND IS NOT INTENDED TO PROVIDE
LEGAL DIMENSIONS OR LOCATION OF PROPERTY OWNERSHIP LINES.

RECEIVED
APR 08 2019
OWRD