


T32S, R32.5E, W.M.
Harney County, Oregon

RECEIVED

AUG 12 2019

OWRD

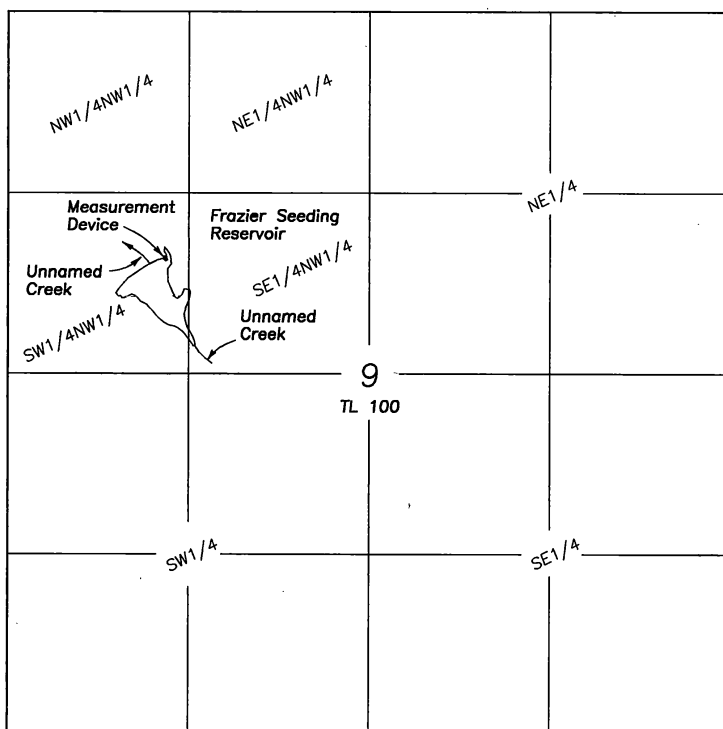

SCALE 1"=1320'

Outlet is located 3450' North & 1170' East of the
SW corner of Section 9.

Measuring device is located 20' N & 20' W of the Outlet.

FINAL PROOF SURVEY
CLAIM OF BENEFICIAL USE
FRAZIER SEEDING RESERVOIR

For

Bureau of Land Management

June 24, 2019

LEGEND

Application No. R-69356
Permit No. R-11886
Priority 12/31/1991

A portion of Tax Lot
32-32.5 TL100

NOTE: Tax Lot 100 is owned by the BLM
and is more that 22,000 acres.
A portion of the tax lot boundary
is shown.

NOTE: The preparation of this map
was for the purpose of identifying
the location of the proposed water
right and has no intent to provide
dimensions or location of property
ownership lines.

Prepared by
Cornerstone Surveying, Inc

P.O. BOX 33
JOHN DAY, OR. 97845
(541)575-1813
jwsurvey55@gmail.com

