
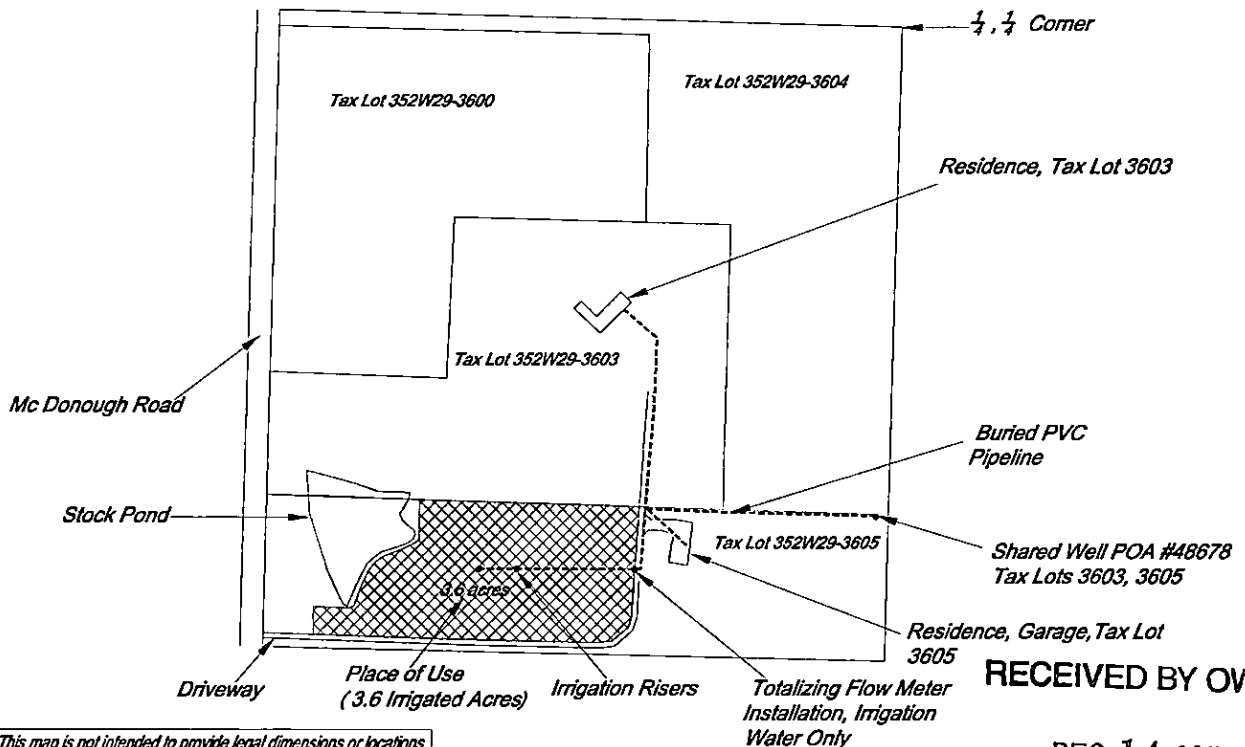
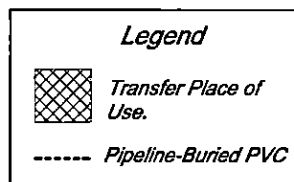


Water Right Place of Use Transfer Application T-11835
Claim of Beneficial Use Map

T. 35S, R. 2W, WM, Jackson County, Oregon

Well-POA location : SW $\frac{1}{4}$ NW $\frac{1}{4}$ Section 29, Township 35S, Range 2W, WM:
2930 feet North and 1300 feet East from the SW Corner of Section 29

Well-POA location Coordinates, Latitude-Longitude (degrees)
Latitude: 42.4991284°, Longitude: -122.9695184°

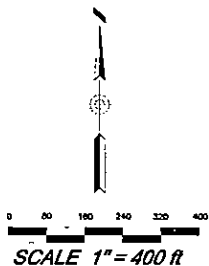

This map is not intended to provide legal dimensions or locations of property ownership lines. Site visit date=Oct 10, 2015

RECEIVED BY OWRD

DEC 14 2015

SALEM, OR