CLAIM OF BENEFICIAL USE MAP

T3S R5W, SECTIONS 13, 14, 23 & 24 WM.,
TAXLOTS 100, 104 & 105
YAMHILL COUNTY, OREGON
APPLICATION S-85995 PERMIT S-54233
APPLICATION S-86050 PERMIT S-54234

PREPARED FOR:
JACKSON FAMILY INVESTMENTS III, LLC
421 AVIATION BLVD
SANTA ROSA, CA 95403

SECTION	TAXLOT	QTR-QTR	DLC	ACRES
13	100	SW-SW	53	27.2
13	100	SE-SW	53	9.1
13	100	SE-SW	41	6.1 ~~5.1~~
13	100	SW-SE	41	3.7
14	100	SE-SE	53	16.3
23	100	NE-NE	53	5.9
24	100	NW-NW	53	24.1
24	100	NE-NW	53	3.6 ~~2.1~~
24	104	NE-NW	53	0.1
24	100	NE-NW	41	0.5
24	100	SW-NW	53	1.9
24	104	SW-NW	53	17.3
24	104	SE-NW	53	15.2
24	104	SE-NW	41	4.2
24	104	SW-NE	41	0.4
24	104	NW-SW	53	1.5
24	105	NW-SW	53	10.3
24	104	NE-SW	53	2.7
24	105	NE-SW	53	10.5
24	105	NE-SW	41	7.7
24	105	NW-SE	41	0.5
24	105	SW-SW	53	3.6
24	105	SE-SW	53	8.4
24	105	SE-SW	41	8.3
24	105	SW-SE	41	0.5
		TOTAL IRR ACR		~~193.7~~ 195.4 AC
24	104	NE-SW	41	0.6

Revised 5/21/2019

THICK DASHED LINES ARE PIPES. 6" PVC PIPE FROM POD 1 AND 2 TO POND G. 4" PVC PIPE GOES FROM POD 3 (POND G) TO ALL OTHER PONDS.

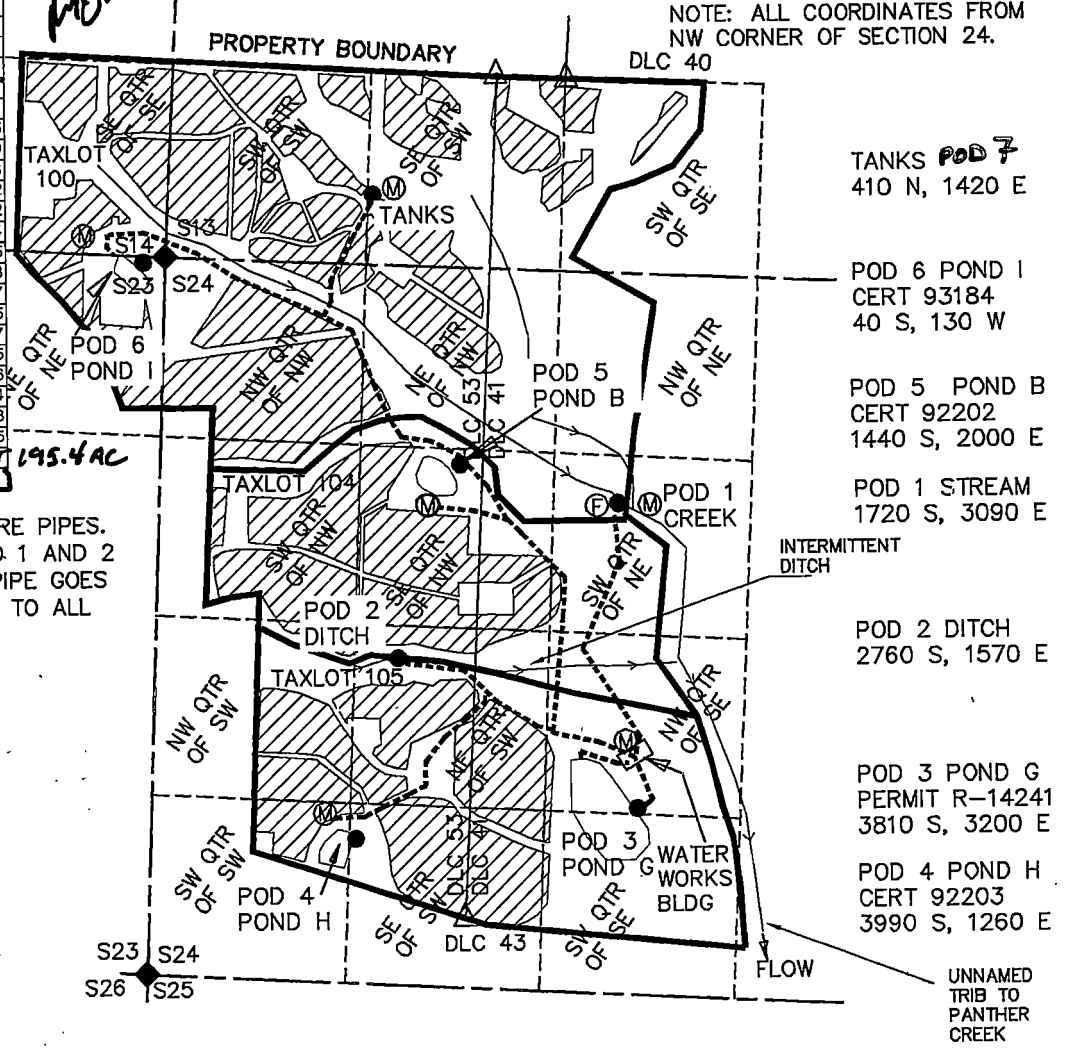

LEGEND

IRRIG AND SUPPL IRRIG AREAS.

TAX LOT LINES
FISH SCREEN LOCATION
METER LOCATION
SECTION CORNER
POINT OF DIVERSION – POD
DLC CORNER
MAIN LINES

TAX LOT	IRR ACRE
100	102.5
104	42.2
105	49.8
TOTAL	193.7

THIS MAP WAS PREPARED FOR THE PURPOSE OF IDENTIFYING THE LOCATION OF A WATER RIGHT ONLY AND IS NOT INTENDED TO PROVIDE LEGAL DIMENSIONS OR LOCATION OF PROPERTY OWNERSHIP LINES.

N

1320 0 660 1320

1 inch = 1320 ft.

Certified Water Right Examiner
#60125
Jeffrey A. Kee
STATE OF OREGON
expires 6/30/2019

Stuntzner Engineering & Forestry, LLC

Project: 308-2-015
Drawing: 3082015JCOBUMaps.dwg
By: JAK
Date: MARCH 15, 2018