

CLAIM OF BENEFICIAL USE MAP


T3S R5W, SECTIONS 13, 14, 23 & 24 WM.,
 TAXLOTS 100, 104 & 105
 YAMHILL COUNTY, OREGON
 APPLICATION S-85995 PERMIT S-54233
 APPLICATION S-86050 PERMIT S-54234

PREPARED FOR:
JACKSON FAMILY INVESTMENTS III, LLC
 421 AVIATION BLVD
 SANTA ROSA, CA 95403

SECTION	TAXLOT	QTR-QTR	DLC	ACRES
13	100	SW-SW	53	27.2
13	100	SE-SW	53	9.1
13	100	SE-SW	41	6.1
13	100	SW-SE	41	3.7
14	100	SE-SE	53	16.3
23	100	NE-NE	53	5.9
24	100	NW-NW	53	24.1
24	100	NE-NW	53	0.5
24	104	NE-NW	53	0.1
24	100	NE-NW	41	0.5
24	100	SW-NW	53	1.9
24	104	SW-NW	53	17.3
24	104	SE-NW	53	15.2
24	104	SE-NW	41	4.2
24	104	SW-NE	41	0.4
24	104	NW-SW	53	1.5
24	105	NW-SW	53	10.3
24	104	NE-SW	53	2.7
24	105	NE-SW	53	10.5
24	105	NE-SW	41	7.7
24	105	NW-SE	41	0.5
24	105	SW-SW	53	3.6
24	105	SE-SW	53	8.4
24	105	SE-SW	41	8.3
24	105	SW-SE	41	0.5
TOTAL IRR ACR				193.7
24 104 NE-SW 41				0.6

*Revised
5/21/2019
JAK*

NOTE: ALL COORDINATES FROM
 NW CORNER OF SECTION 24.
 DLC 40

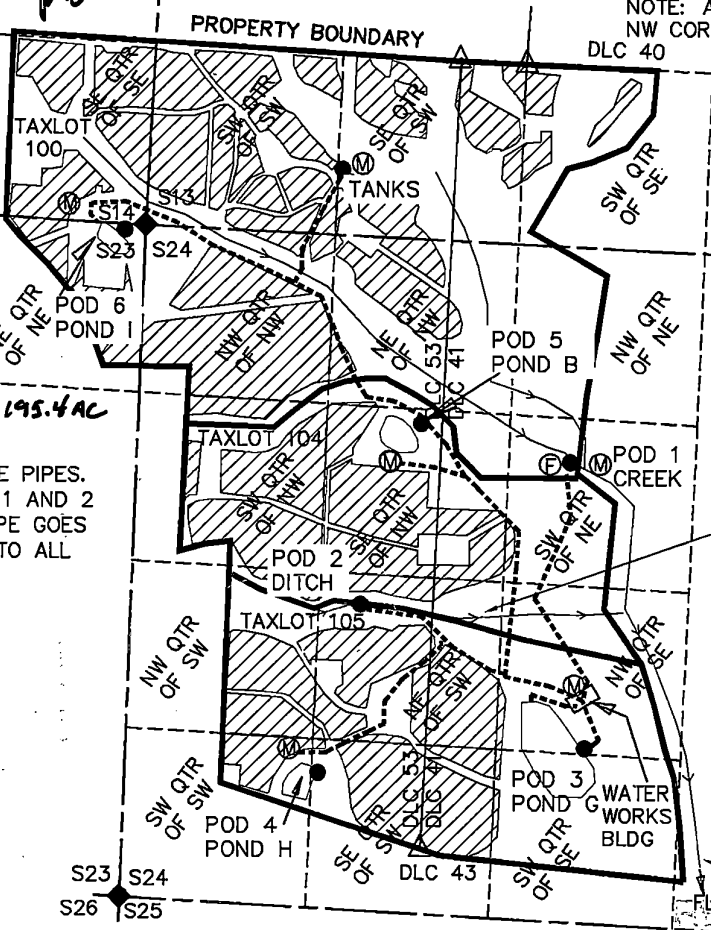


- TANKS **POD 7**
410 N, 1420 E
- POD 6 POND I
CERT 93184
40 S, 130 W
- POD 5 POND B
CERT 92202
1440 S, 2000 E
- POD 1 STREAM
1720 S, 3090 E
- POD 2 DITCH
2760 S, 1570 E
- POD 3 POND G
PERMIT R-14241
3810 S, 3200 E
- POD 4 POND H
CERT 92203
3990 S, 1260 E
- UNNAMED
TRIBUTARY TO
PANTHER
CREEK

THICK DASHED LINES ARE PIPES.
 6" PVC PIPE FROM POD 1 AND 2
 TO POND G. 4" PVC PIPE GOES
 FROM POD 3 (POND G) TO ALL
 OTHER PONDS.

LEGEND

- IRRIG AND SUPPL IRRIG AREAS.
- TAX LOT LINES
- FISH SCREEN LOCATION
- METER LOCATION
- SECTION CORNER
- POINT OF DIVERSION - POD
- DLC CORNER
- MAIN LINES

TAX LOT	IRR ACRE
100	102.5
104	42.2
105	49.8
TOTAL	193.7

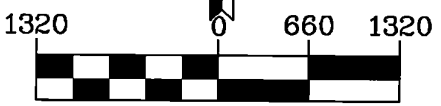

1 inch = 1320 ft.



Project: 308-2-015
 Drawing: 3082015JCOBUMaps.dwg
 By: JAK
 Date: MARCH 15, 2018

MAR 20 2018

THIS MAP WAS PREPARED FOR THE PURPOSE
 OF IDENTIFYING THE LOCATION OF A WATER
 RIGHT ONLY AND IS NOT INTENDED TO
 PROVIDE LEGAL DIMENSIONS OR LOCATION OF
 PROPERTY OWNERSHIP LINES.