



T23S R34E & T24S R34E, WM

HARNEY COUNTY, OREGON

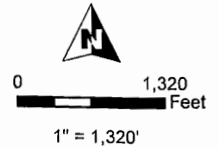

RECEIVED
 FEB 12 2019
 OWRD

- Well
- ⊙ Meter
- POU IR 1-14-1963 & 9-23-1968
- Township
- Section
- Quarter Quarter
- Tax Lot

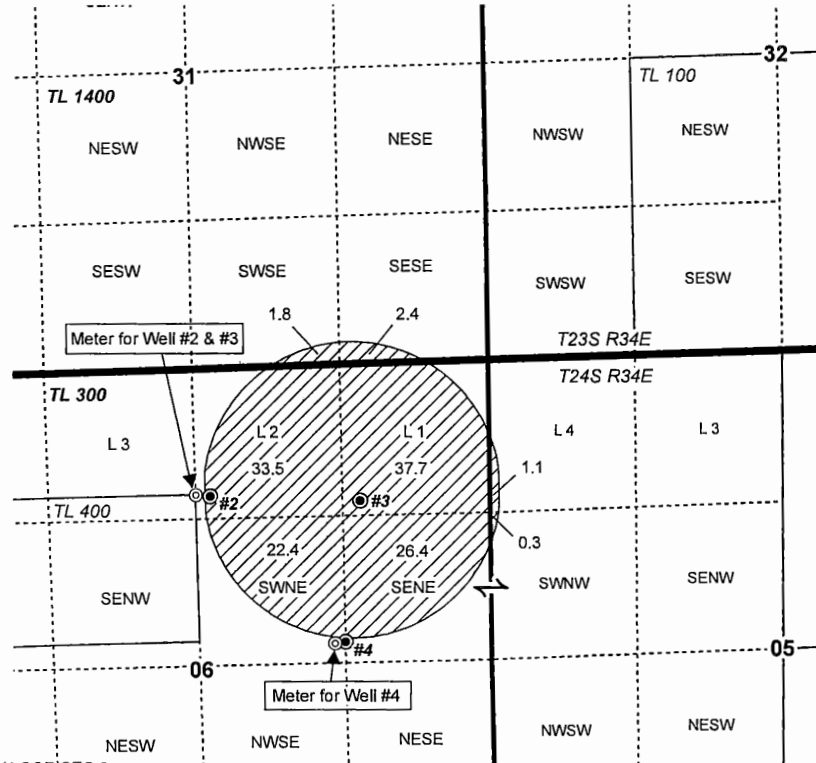

RENEWAL DATE 12/31/2019

WELL LOCATIONS:

#2 (HARN 1055/L-133203): 1,130' S, 160' E OF N 1/4 COR SEC 6
 Lat: N 43.518902 DD, Long: W -118.579096 DD

#3 (HARN 1054/L-133202): 1,170' S, 1,500' E OF N 1/4 COR SEC 6
 Lat: N 43.518858 DD, Long: W -118.574243 DD

#4 (HARN 51072/L-71057): 230' N, 1,300' E OF CTR COR SEC 6
 Lat: N 43.515222 DD, Long: W -118.575170 DD



CLAIM OF BENEFICIAL USE MAP
Badger Ventures, LLC

NOTE: THIS MAP IS NOT INTENDED TO
 PROVIDE LEGAL DIMENSIONS OR LOCATIONS
 OF PROPERTY OWNERSHIP LINES.

WATER RIGHT SERVICES, LLC



PO BOX 1830, BEND, OR 97709

CCB# 197121 www.oregonwater.us

541-389-2837 JOHNSHORT@USA.COM

T 22 S R 33 E, Sec 34, WM

HARNEY COUNTY, OREGON

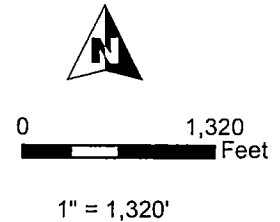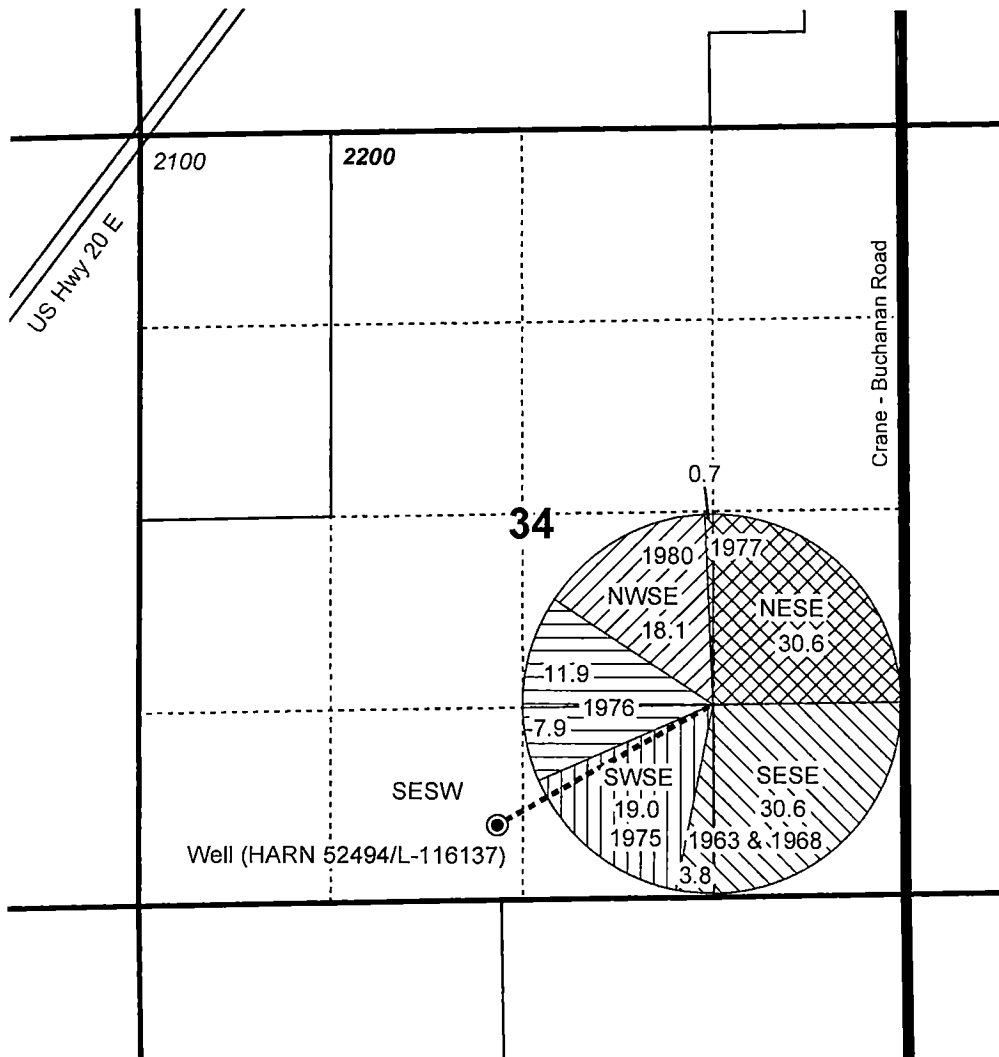


RECEIVED

FEB 12 2019

CWRD

Well (HARN 52494/L-116137): 500' N, 2320' E of SW Cor S34
Lat: N 43.610087 DD, Long: W -118.639748 DD

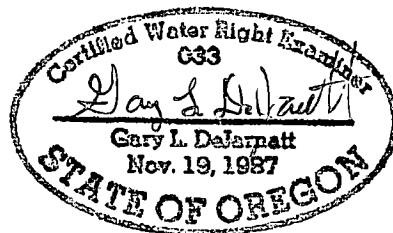

RENEWAL DATE 12/31/2019



Well & Meter



POU IS 6-6-1980



POU IS 1-18-1977



POU IS 10-25-1976



POU IS 12-5-1975



POU IS 1-14-1963 & 9-23-1968



Buried Pipeline



Sections



Tax Lots



Quarter Quarter

CLAIM OF BENEFICIAL USE MAP
Badger Ventures, LLC

This map is not intended
to provide legal dimensions
or locations of property
ownership lines.

Date: 1/14/2019

WATER RIGHT SERVICES, LLC

PO BOX 1830, BEND, OR 97709

WWW.OREGONWATER.US CCB # 197121

johnshort@usa.com

541-389-2837