

APPLICATION MAP FOR CHANGE IN POA FOR
LOT 1 REDTAIL MEADOWS SUBDIVISION FOR
C. 86742 LOCATED IN SE1/4 SW1/4 OF
SECTION 12 AND IN NE1/4 NW1/4 OF
SECTION 13, T.16S., R.16E., W.M., CROOK
COUNTY, OREGON W.O. 15-4626


T-

SCALE

1" = 200'

0200400

MAY 27, 2015

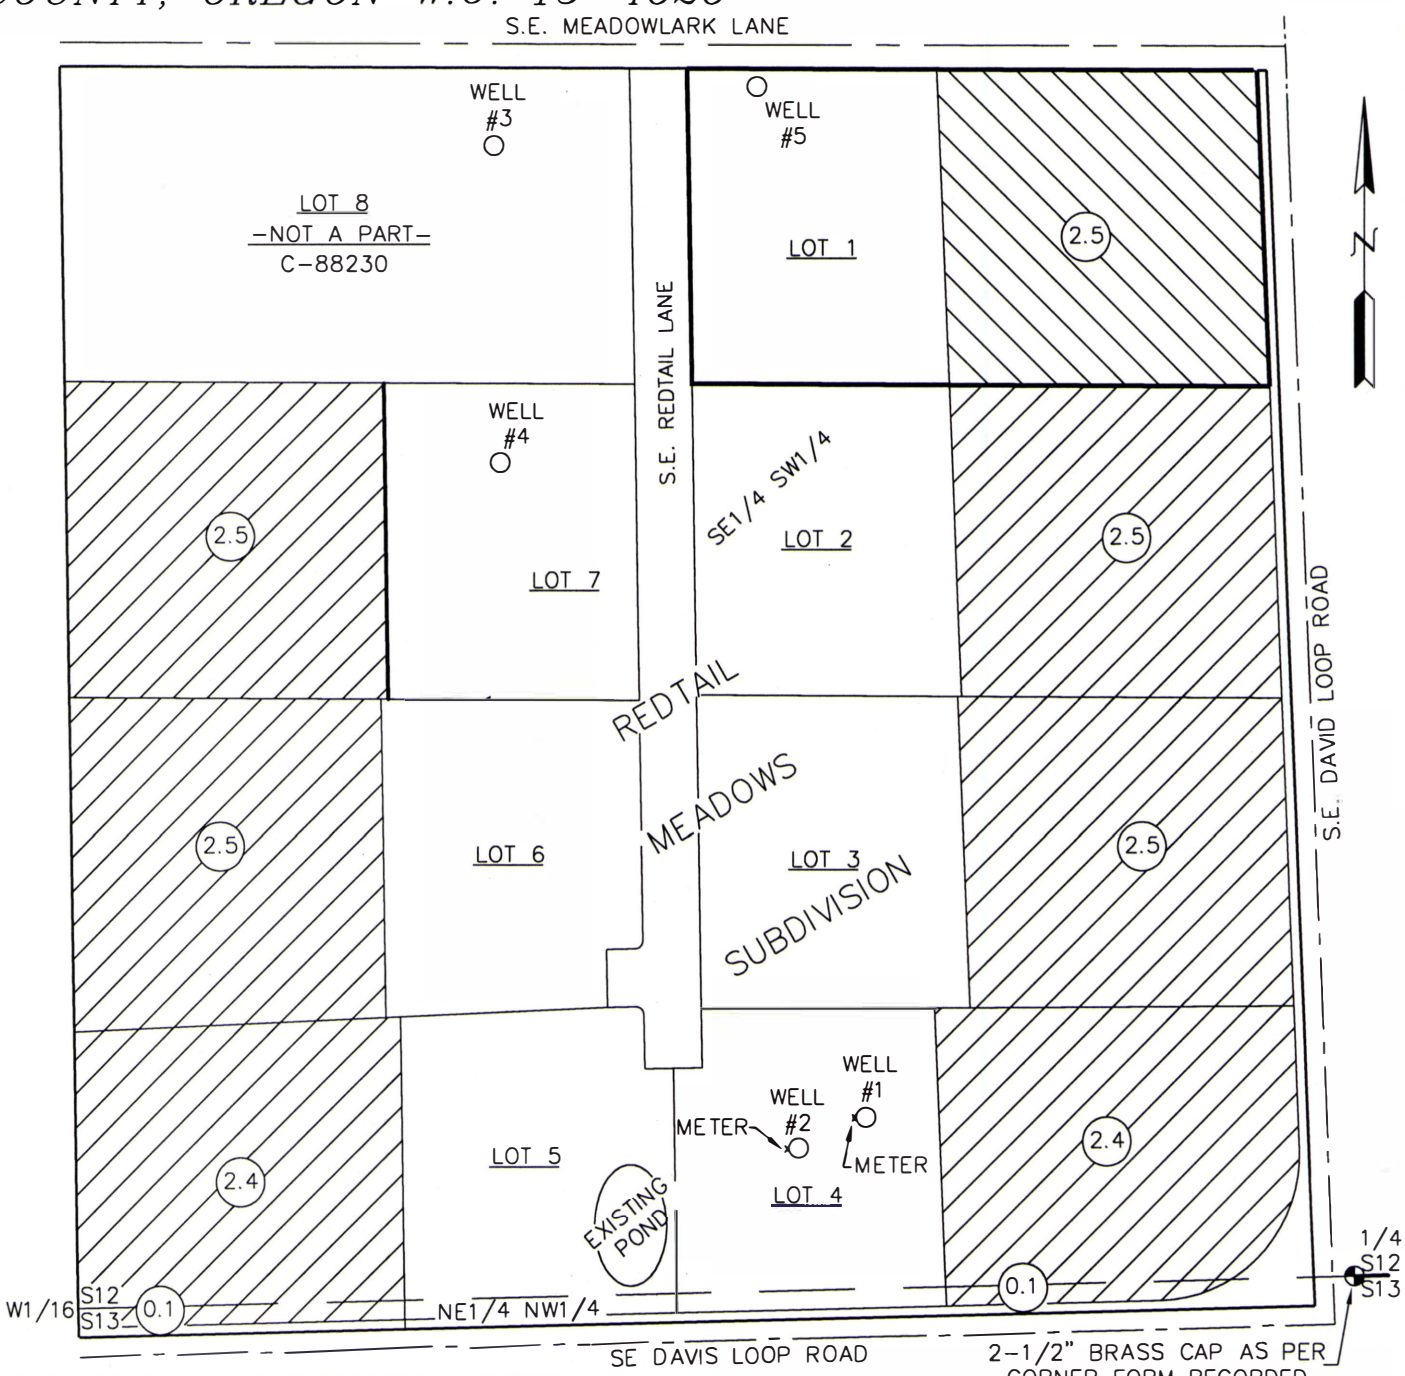

PREPARED FOR PREPARED BY

JACOB D. McNAUGHTON
KATIE S. McNAUGHTON
P.O. BOX 1527
PRINEVILLE, OR 97754
(541)233-4469

ARMSTRONG SURVEYING
& ENGINEERING, INC
267 NE SECOND ST. STE 100
PRINEVILLE, OR 97754
(541) 447-7791

WATER RIGHTS
PRIMARY - C-86742 - NO CHANGE
T.16S., R.16E., W.M. TOTAL - 15.0 AC.

MAP 16-16-12C	PLAT	SECTION 12	SECTION 13
TAX LOT	LOT	SE1/4 SW1/4	NE1/4 NW1/4
701	2	2.5 AC.	-
702	3	2.5 AC.	-
703	4	2.4 AC.	0.1 AC.
704	5	2.4 AC.	0.1 AC.
705	6	2.5 AC.	-
706	7	2.5 AC.	-
	TOTAL	14.8 AC.	0.2 AC.

EXISTING WELL LOCATIONS - CERTIFICATE 86742
WELL #1 - LOCATED IN SE1/4 SW1/4 SECTION 12, T.16S., R.16E., W.M., 178 FT. NORTH AND 510 FT. WEST OF THE S1/4 CORNER SECTION 12.
WELL #2 - LOCATED IN SE1/4 SW1/4 SECTION 12, T.16S., R.16E., W.M., 147 FT. NORTH AND 581 FT. WEST OF THE S1/4 CORNER SECTION 12.
CHANGE IN POINT OF APPROPRIATION - LOCATION
WELL #5 - LOCATED IN SE1/4 SW1/4 SECTION 12, T.16S., R.16E., W.M., 1230 FT. NORTH AND 622 FT. WEST OF THE S1/4 CORNER SECTION 12.


PRIMARY - C-86742 - CHANGE POA
T.16S., R.16E., W.M. TOTAL - 2.5 AC.

MAP 16-16-12C	PLAT	SECTION 12	SECTION 13
TAX LOT	LOT	SE1/4 SW1/4	NE1/4 NW1/4
700	1	2.5 AC.	-

RECEIVED BY OWRD

FEB 12 2016

SALEM, OR

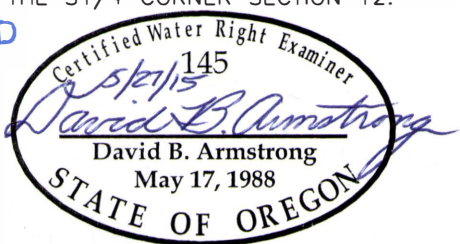

MAP NOTE

Renews December 31, 2015

T 12280


THE PREPARATION OF THIS MAP IS FOR THE PURPOSE OF IDENTIFYING THE LOCATION OF THE WATER RIGHT ONLY AND HAS NO INTENT TO PROVIDE DIMENSIONS OR LOCATIONS OF PROPERTY OWNERSHIP LINES.

DRG. NO. 10-3985.DWG
W.O. 15-4626

FINAL PROOF SURVEY MAP LOCATED
IN SE1/4 SW1/4 OF SECTION 12 AND IN
NE1/4 NW1/4 OF SECTION 13, T.16S., R.16E.,
W.M., CROOK COUNTY, OREGON
W.O. 07-3591

COBU MAP # 0334

RECEIVED
JUN 14 2007

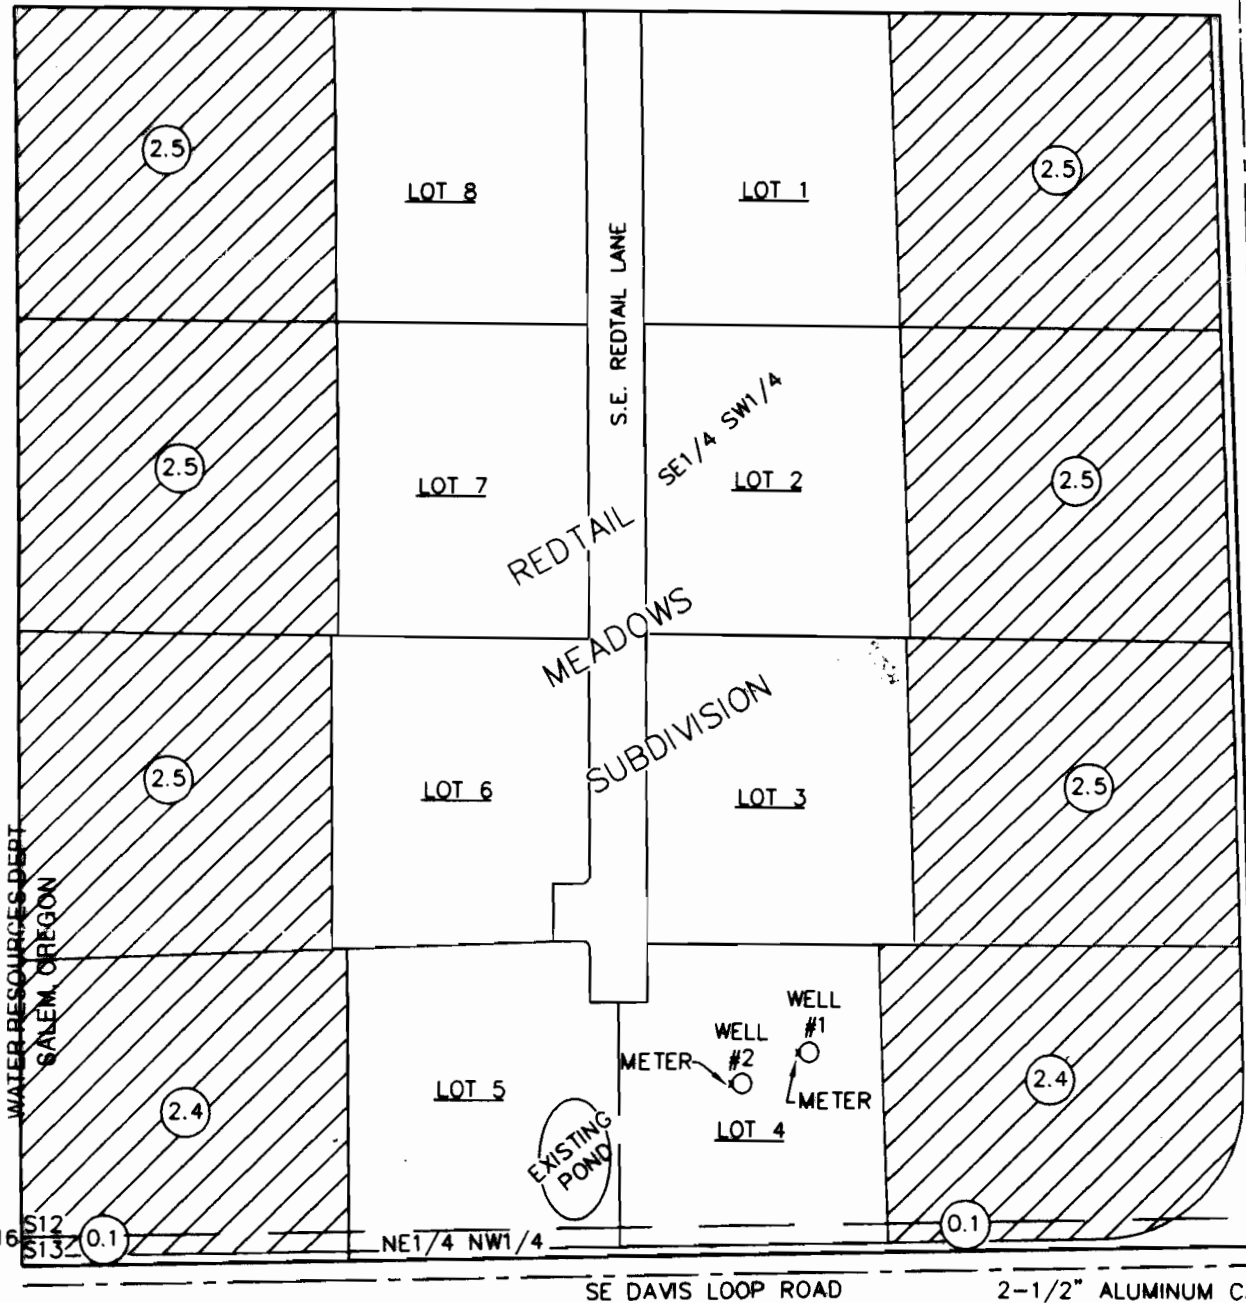

SURVEYED FOR SURVEYED BY

RIVERS BEND DEVELOPMENT, LLC
C/O BROOK HAVENS, MEMBER
5055 NE MCKAY CREEK RD.
PRINEVILLE, OR 97754
(541) 447-1682

ARMSTRONG SURVEYING
& ENGINEERING, INC
267 NE SECOND ST. STE 100
PRINEVILLE, OR. 97754
(541) 447-7791

WELL LOCATIONS

WELL #1 - LOCATED IN SE1/4 SW1/4 SECTION 12, T.16S.,
R.16E., W.M., 178 FT. NORTH AND 510 FT.
WEST OF THE S1/4 CORNER SECTION 12.


WELL #2 - LOCATED IN SE1/4 SW1/4 SECTION 12, T.16S.,
R.16E., W.M., 147 FT. NORTH AND 581 FT.
WEST OF THE S1/4 CORNER SECTION 12.

MAP NOTE

THE PREPARATION OF THIS MAP IS FOR THE PURPOSE OF
IDENTIFYING THE LOCATION OF THE WATER RIGHT ONLY
AND HAS NO INTENT TO PROVIDE DIMENSIONS OR
LOCATIONS OF PROPERTY OWNERSHIP LINES.

SCALE

1" = 200'

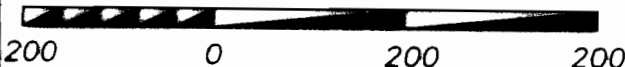


JUNE 13, 2007

WATER RIGHTS



PRIMARY - PERMIT G-11684 T.16S., R.16E., W.M.
TOTAL - 20.0 AC.

MAP 16-16-12C	PLAT	SECTION 12	SECTION 13
TAX LOT	LOT	SE1/4 SW1/4	NE1/4 NW1/4
700	1	2.5 AC.	-
701	2	2.5 AC.	-
702	3	2.5 AC.	-
703	4	2.4 AC.	0.1 AC.
704	5	2.4 AC.	0.1 AC.
705	6	2.5 AC.	-
706	7	2.5 AC.	-
707	8	2.5 AC.	-
TOTAL		19.8 AC.	0.2 AC.

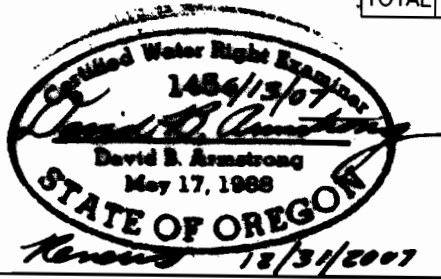

SHEET 1 OF 1
DRG. NO. 07-3591WR.DWG

W.O. 07-3591

A horizontal scale bar with major tick marks at 0, 100, 200, 300, and 400 feet. The text "0 100 200 300 400 Feet" is positioned above the bar.

16S16E12C

**Cancelled
1800**

RECEIVED BY OWRD


MAY 21 2015

SALEM, OR

Permanent Transfer Application Form – Page 12 of 12

Revised 7/1/2013

TACS

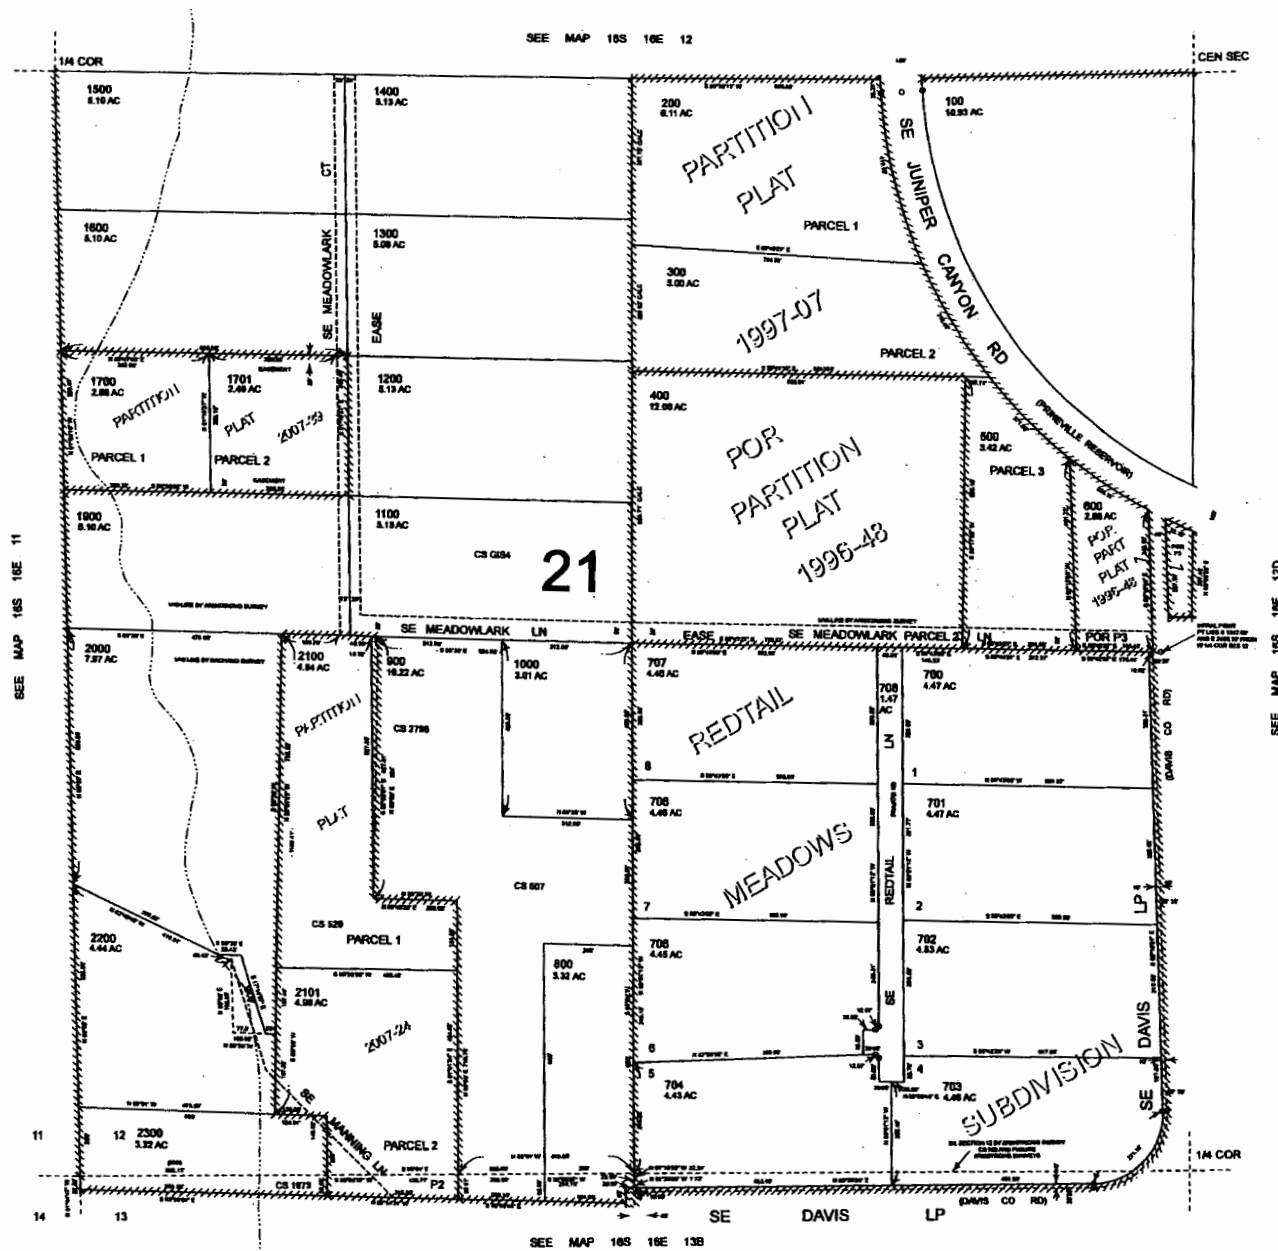

Revised: EB
8/25/2008


16S16E12C

APPLICATION MAP FOR CHANGE IN POA AND
POU FOR LOT 7 REDTAIL MEADOWS
SUBDIVISION FOR C. 86742 LOCATED IN SE1/4
SW1/4 OF SECTION 12 AND IN NE1/4 NW1/4
OF SECTION 13, T.16S., R.16E., W.M., CROOK
COUNTY, OREGON W.O. 15-4612

T-12064



SCALE

1" = 200'

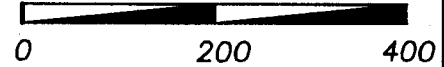

MAY 18 2015

S.E. MEADOWLARK LANE

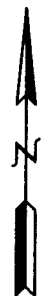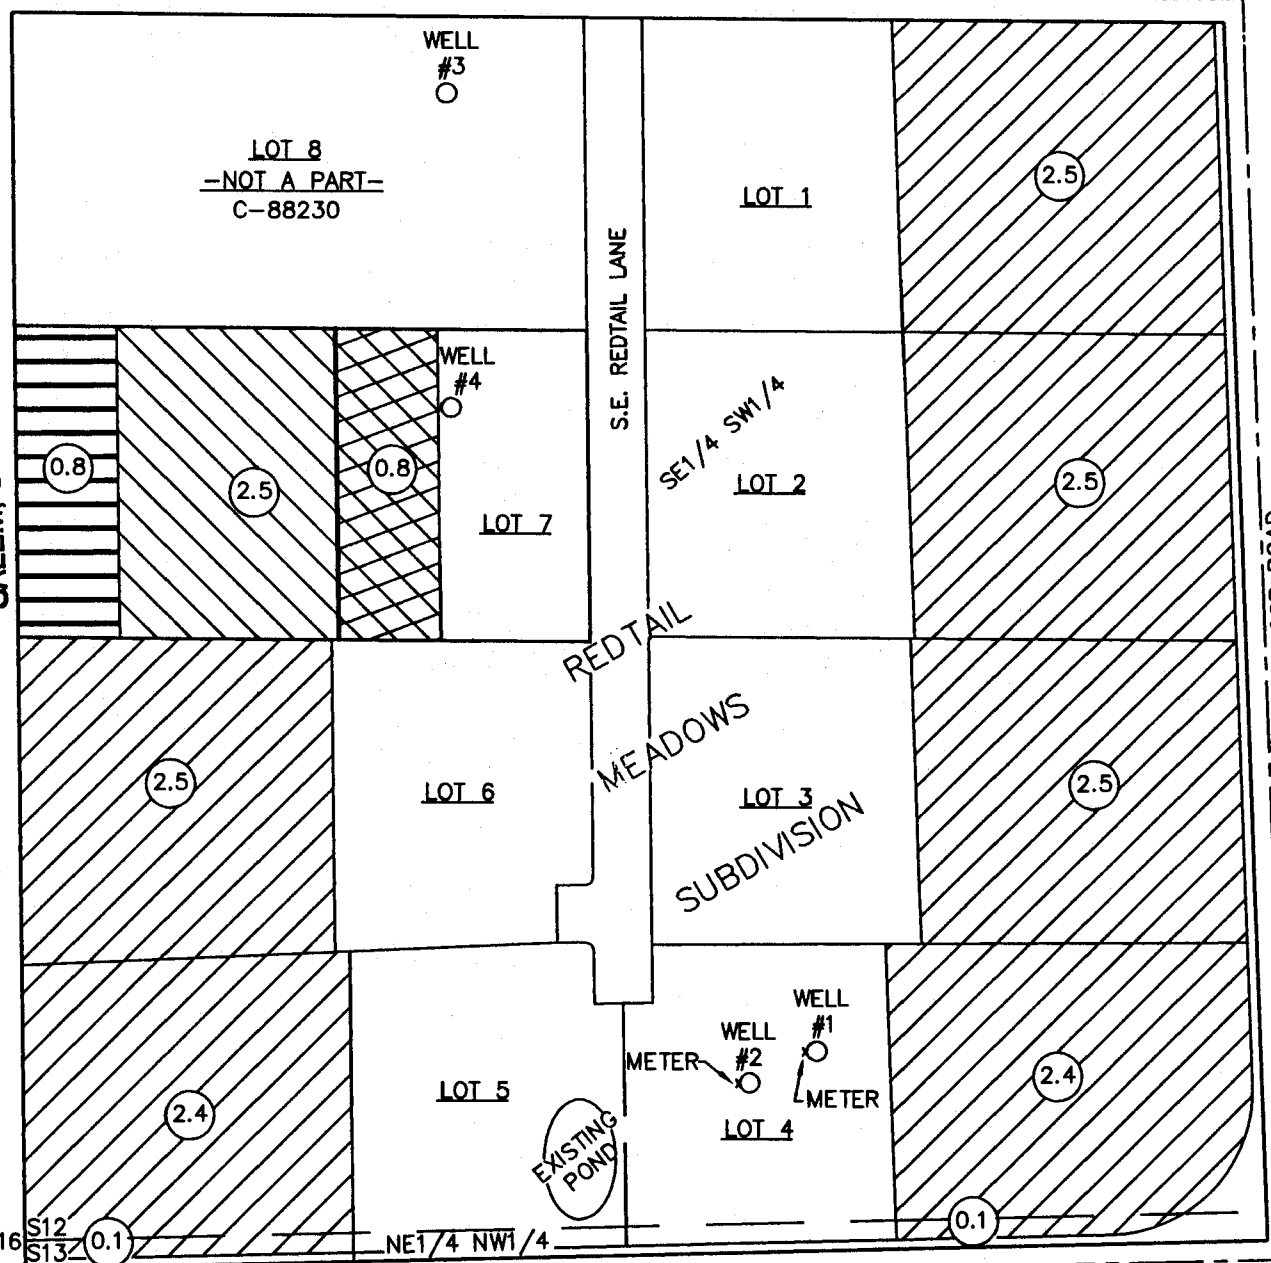

RECEIVED BY OWRD

MAY 21 2015

SALEM, OR

PREPARED FOR PREPARED BY

DAVID L. PETERSON
ROSEMARY PETERSON
P.O. BOX 1588
PRINEVILLE, OR 97754
(541)490-6524

ARMSTRONG SURVEYING
& ENGINEERING, INC
267 NE SECOND ST. STE 100
PRINEVILLE, OR 97754
(541) 447-7791


EXISTING WELL LOCATIONS - CERTIFICATE 86742

WELL #1 - LOCATED IN SE1/4 SW1/4 SECTION 12, T.16S.,
R.16E., W.M., 178 FT. NORTH AND 510 FT.
WEST OF THE S1/4 CORNER SECTION 12.

WELL #2 - LOCATED IN SE1/4 SW1/4 SECTION 12, T.16S.,
R.16E., W.M., 147 FT. NORTH AND 581 FT.
WEST OF THE S1/4 CORNER SECTION 12.

CHANGE IN POINT OF APPROPRIATION - LOCATION

WELL #4 - LOCATED IN SE1/4 SW1/4 SECTION 12, T.16S.,
R.16E., W.M., 840 FT. NORTH AND 900 FT.
WEST OF THE S1/4 CORNER SECTION 12.

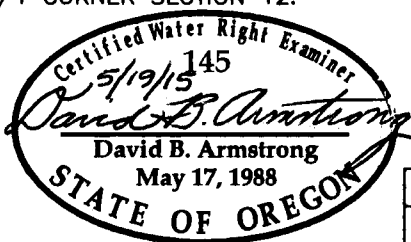

MAP NOTE

Renews December 31, 2015

THE PREPARATION OF THIS MAP IS FOR THE PURPOSE OF IDENTIFYING
THE LOCATION OF THE WATER RIGHT ONLY AND HAS NO INTENT TO
PROVIDE DIMENSIONS OR LOCATIONS OF PROPERTY OWNERSHIP LINES.

SE DAVIS LOOP ROAD 2-1/2" ALUMINUM CAP AS PER
CORNER FORM RECORDED JANUARY
23, 1990 BY LS1026

WATER RIGHTS

PRIMARY - C-86742 - NO CHANGE
T.16S., R.16E., W.M. TOTAL - 15.0 AC.

MAP 16-16-12C	PLAT	SECTION 12	SECTION 13
TAX LOT	LOT	SE1/4 SW1/4	NE1/4 NW1/4
700	1	2.5 AC.	-
701	2	2.5 AC.	-
702	3	2.5 AC.	-
703	4	2.4 AC.	0.1 AC.
704	5	2.4 AC.	0.1 AC.
705	6	2.5 AC.	-
TOTAL		14.8 AC.	0.2 AC.

PRIMARY- C-86742
CHANGE POU-
WATER OFF-0.8 AC.
SE1/4 SW1/4 LOT 7

PRIMARY- C-86742
CHANGE POU-
WATER ON-0.8 AC.
SE1/4 SW1/4 LOT 7

PRIMARY - C-86742 - CHANGE POA
T.16S., R.16E., W.M. TOTAL - 2.5 AC.

MAP 16-16-12C	PLAT	SECTION 12	SECTION 13
TAX LOT	LOT	SE1/4 SW1/4	NE1/4 NW1/4
706	7	2.5 AC.	-

DRG. NO. 10-3985.DWG

T 12064 W.O. 15-4612