

Per 1239
946

2419

OFFICE OF STATE ENGINEER
RECEIVED
JUL 2 1910
SALEM, OREGON


Application No.
Permit No.

10527E

Application No. 2419

North

Permit No. 1239

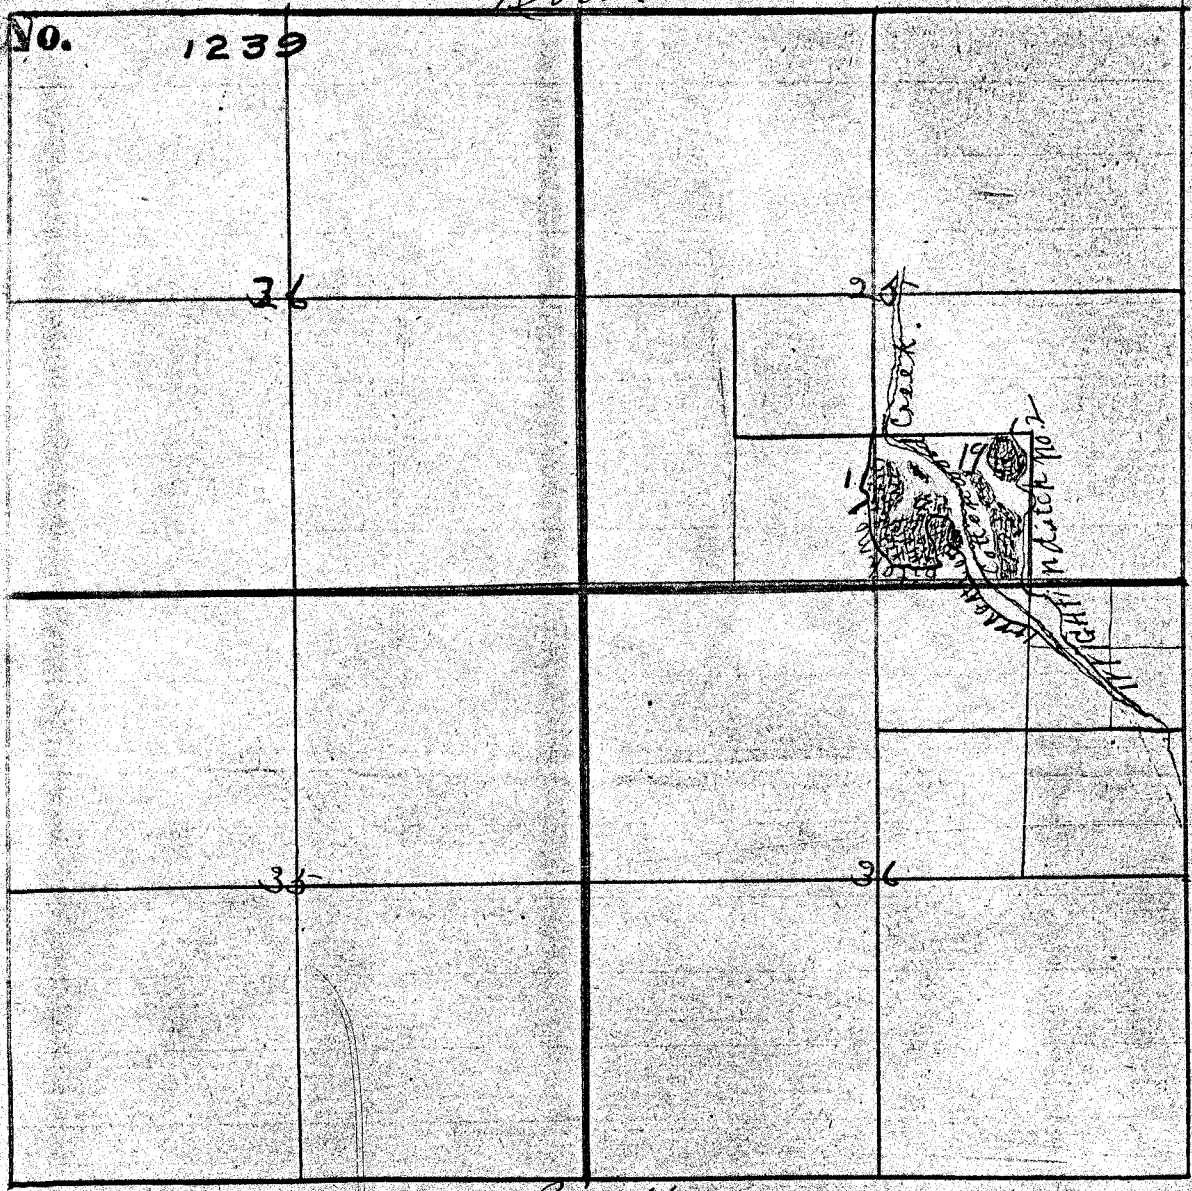

West

East

South