

**NOTES:**

1. THIS MAP WAS PREPARED FROM FIELD MEASUREMENTS, NAIP 2018 AERIAL PHOTOGRAPH, KLAMATH COUNTY TAX MAPS 40-11, 40-11-28, & 40-11-29, AND OREGON GLO MAPS.

2. THE PURPOSE OF THIS MAP IS TO IDENTIFY THE LOCATION OF THE WATER RIGHT ONLY, AND IS NOT INTENDED TO PROVIDE DIMENSIONS OR LOCATION OF PROPERTY LINES.

3. FOR TAX LOT INFORMATION, SEE TAX MAPS INCLUDED WITH THIS APPLICATION.

4. DATE OF PRIORITY FOR THIS WATER RIGHT IS MARCH 6, 1992.

**WELL TIE:**

POA-1 IS LOCATED 1111.4' EAST & 659.5' NORTH OF THE SOUTHWEST CORNER OF SECTION 28, T40S, R11E, W.M. IN THE SW1/4 SW1/4, SECTION 28.

**LEGEND**

	SECTION LINE	29 28		SECTION CORNER
	1/4 1/4 LINE	32 33		
	TAX LOT LINE	TL		TAX LOT NUMBER
	IRRIGATION DITCH LINE	0000		
	☐ ROAD			IRRIGATED UNDER TRANSFER T-12826
	WELL		35.0	IRRIGATED ACRES
			SWSE	1/4 1/4 SECTION


RECEIVED

MAY 24 2019

OWRD

*[Signature]*  
APPLICANT

*[Signature]*  
APPLICANT

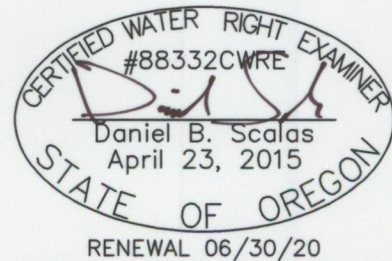

**AL ADKINS** ENGINEERING & SURVEYING  
o / 541.884.4666 w / AdkinsEngineering.com  
1435 ESPLANADE AVENUE, KLAMATH FALLS, OR 97601

SERVING S. OREGON & N. CALIFORNIA

ENGINEERING • SURVEYING • PLANNING • TESTING

**CLAIM OF BENEFICIAL USE AND FINAL PROOF MAP**

FOR  
DELYLE AND DANIELLE DIAZ  
T40S, R11E, SECS. 28 & 29, WM  
KLAMATH COUNTY, OREGON  
TRANSFER T-12826