








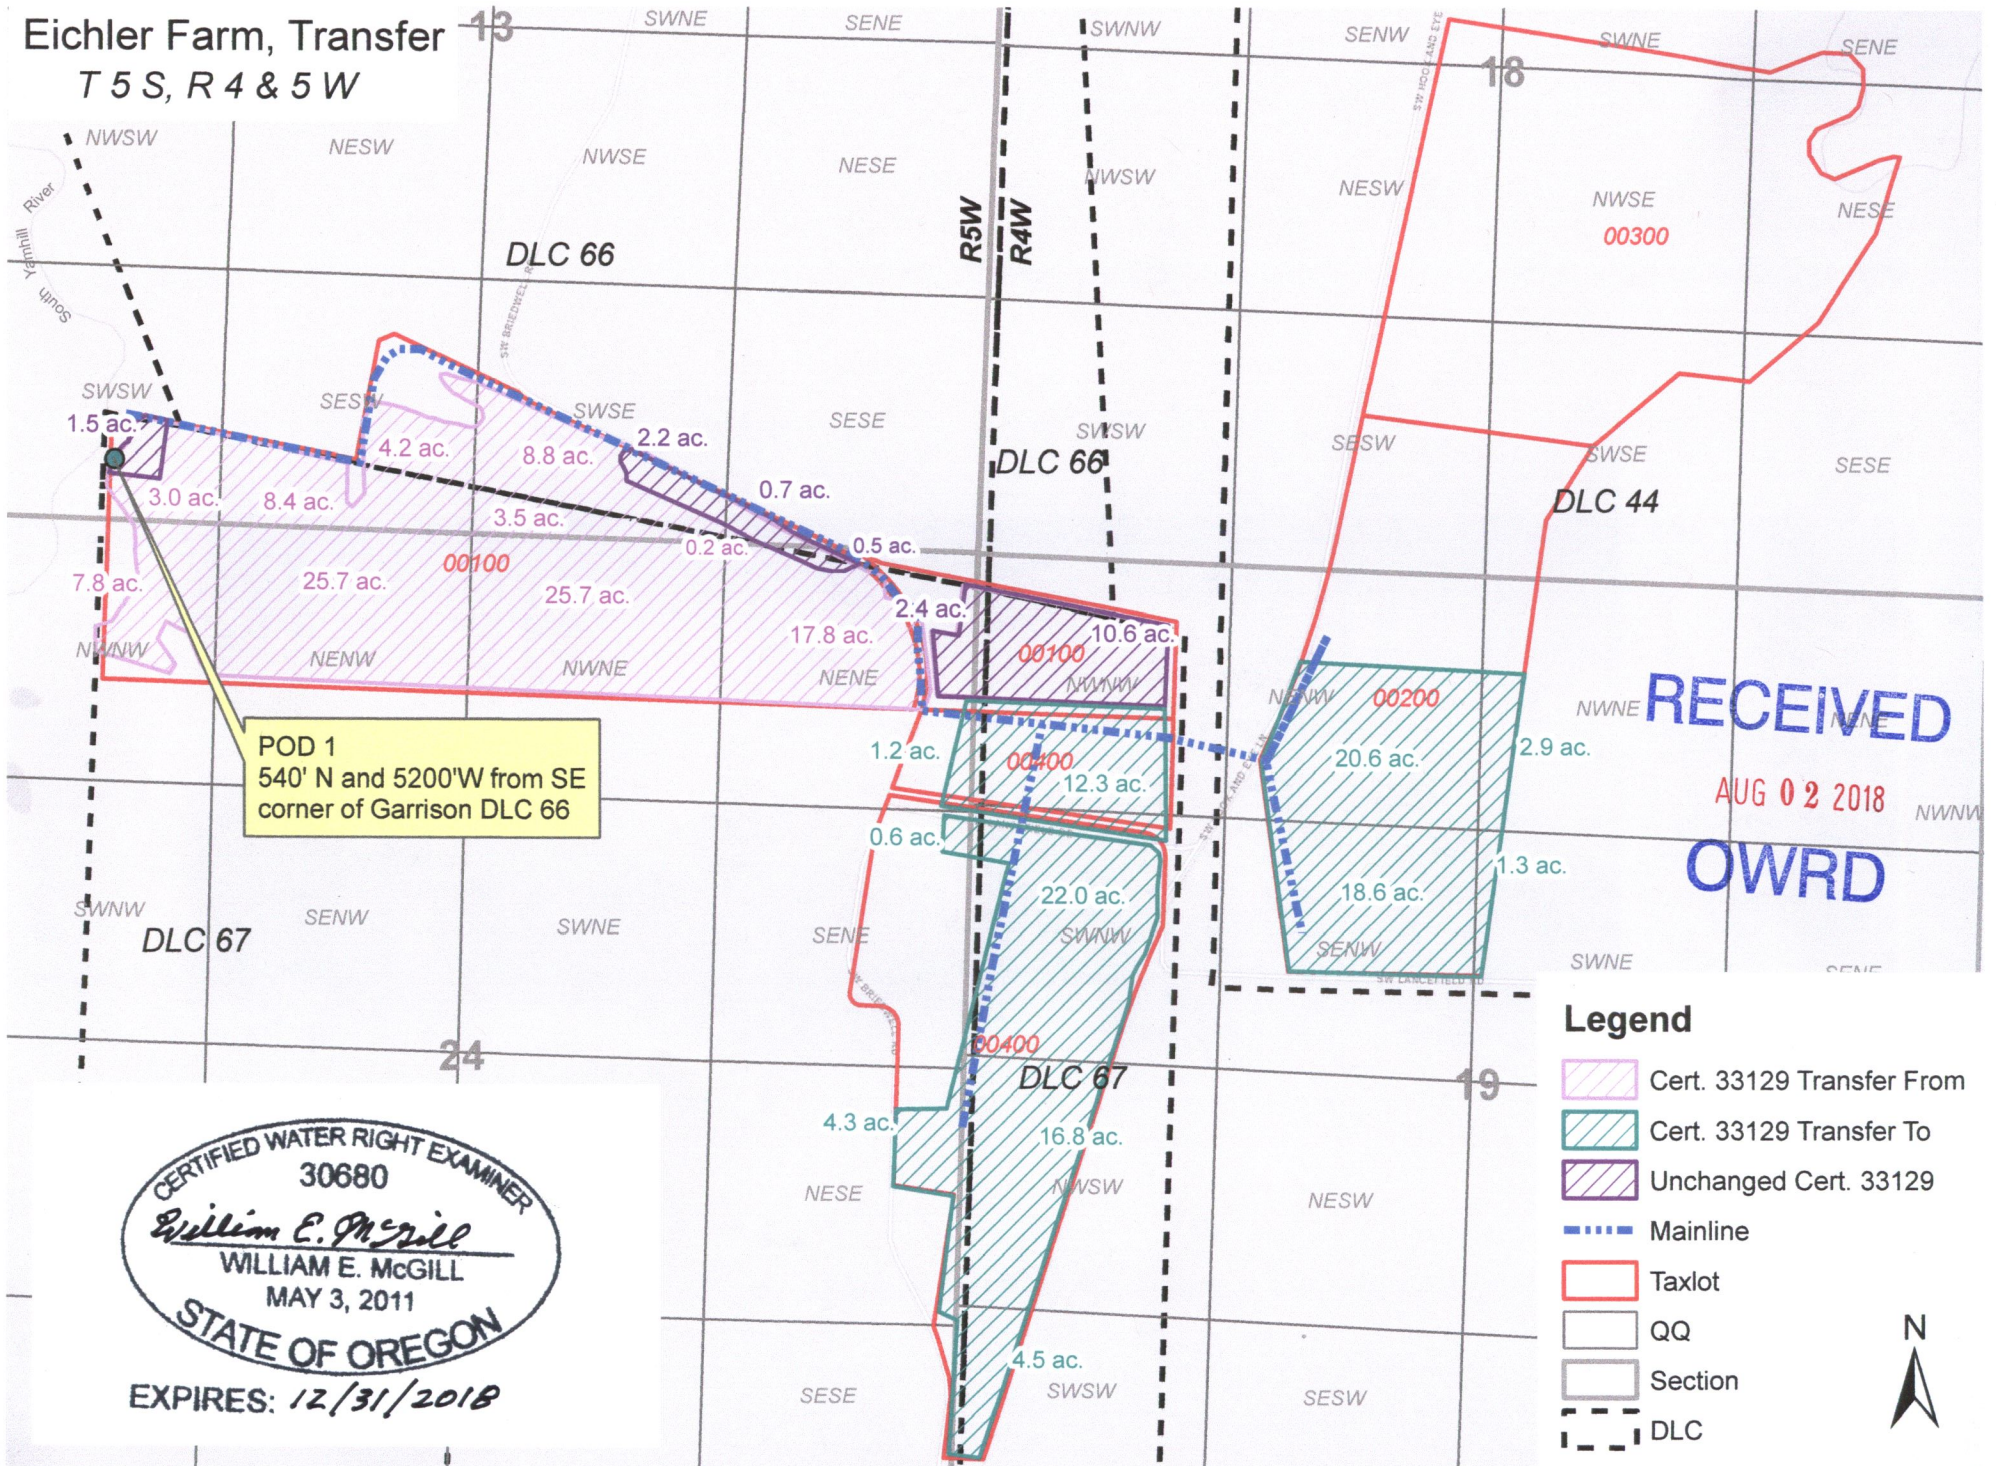

Eichler Farm, Transfer
T 5 S, R 4 & 5 W



POD 1
 540' N and 5200' W from SE
 corner of Garrison DLC 66

CERTIFIED WATER RIGHT EXAMINER
 30680
William E. McGill
 WILLIAM E. MCGILL
 MAY 3, 2011
 STATE OF OREGON
 EXPIRES: 12/31/2018

Legend

-  Cert. 33129 Transfer From
-  Cert. 33129 Transfer To
-  Unchanged Cert. 33129
-  Mainline
-  Taxlot
-  QQ
-  Section
-  DLC