


CLAIM OF BENEFICIAL USE

TRANSFER T-11577

In The Name Of: KIRPAL LIGHT SATSANG, INC.

TOWNSHIP 25 SOUTH, RANGE 7 WEST, W.M.

DOUGLAS COUNTY OREGON

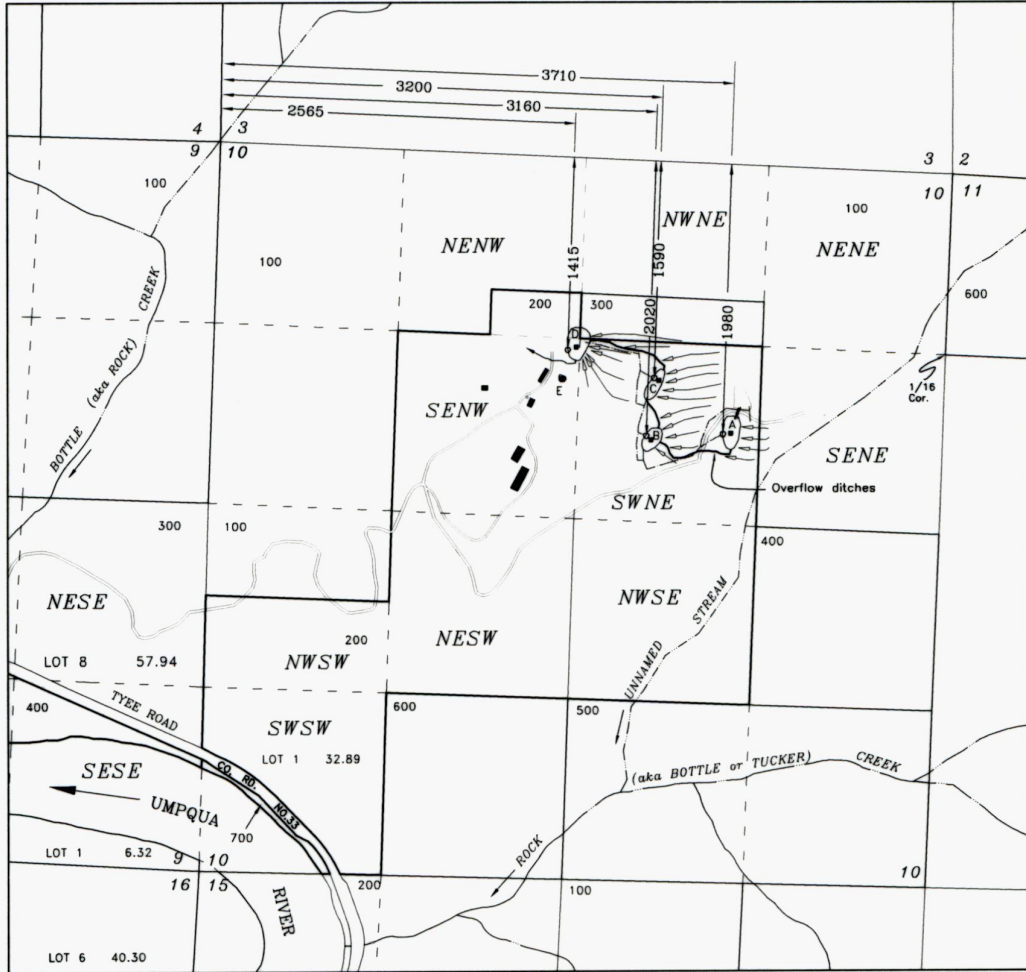

Legend

Scale

1 inch = 1320 feet



NORTH

USE OF WATER - MULTI-PURPOSE

- (A) Reservoir identification (A, B, C, D, E)
 - Staff Gages (A, B, C, D, E)
 - Location of outlets in reservoirs

For purpose of locating outlets, perpendicular directions are referenced from point of beginning (NW COR Section 10) extending along section boundary lines

Spring Spring Seepage - no channel (Reservoirs A-D)

Springs within or at reservoirs are not shown (Reservoirs A-E)

Reservoirs (A-D) are connected via overflow ditches & pipelines so that water collected in upper reservoirs drains to lower reservoirs



JORDAN ENGINEERING
460 JORDAN LANE
ROSEBURG, OR 97471
(541) 673-1931

Drawn 7/1/2015 n.e.d.
Revised 8/19/2015 n.e.d.

This map is not intended to provide legal dimensions or locations of property ownership lines

BASE MAP: Douglas County GIS Tax Lots over 2005 FSA Aerial Photo, Oregon Map aerial photo downloaded May, 2013 & USGS USGS Quadrangle map for assumed best fit