


# T. 35 S., R. 10 E., W.M.

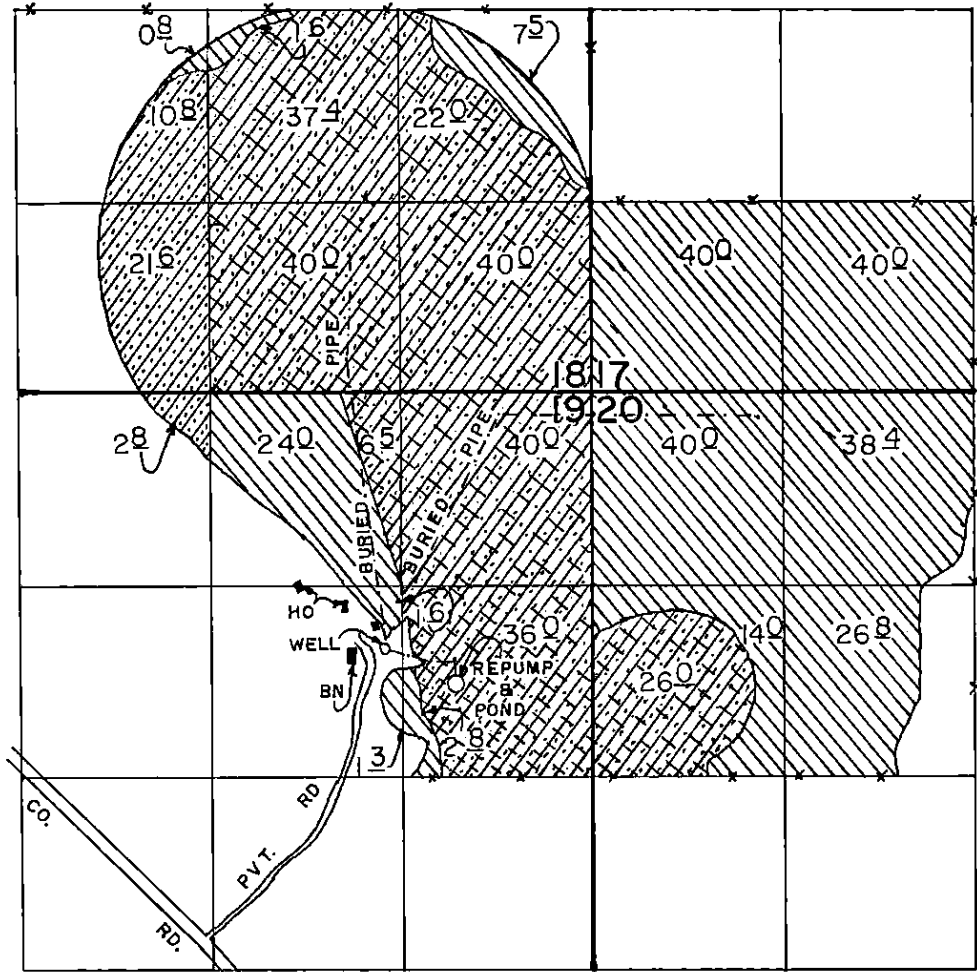

WELL LOC: 1750' S & 1430' W FROM NE COR. OF SEC 19.  
 REPUMP LOC: 1980' S & 940' W FROM NE COR. OF SEC 19.

SCALE: 1" = 1320'

## FINAL PROOF SURVEY

UNDER

Application No. G-8012  
 G-10134  
 G-10850

Permit No. G-9963

IN NAME OF

**GRANT F. BROWN**

Surveyed JULY 28, 1994, by R.M.SUTTERFIELD

PRIORITY DATES

APRIL 11, 1977 SUPPLEMENTAL  
 FEBRUARY 3, 1981 PRIMARY  
 DECEMBER 6, 1992 PRIMARY