


T. 35 S., R. 10 E., W.M.

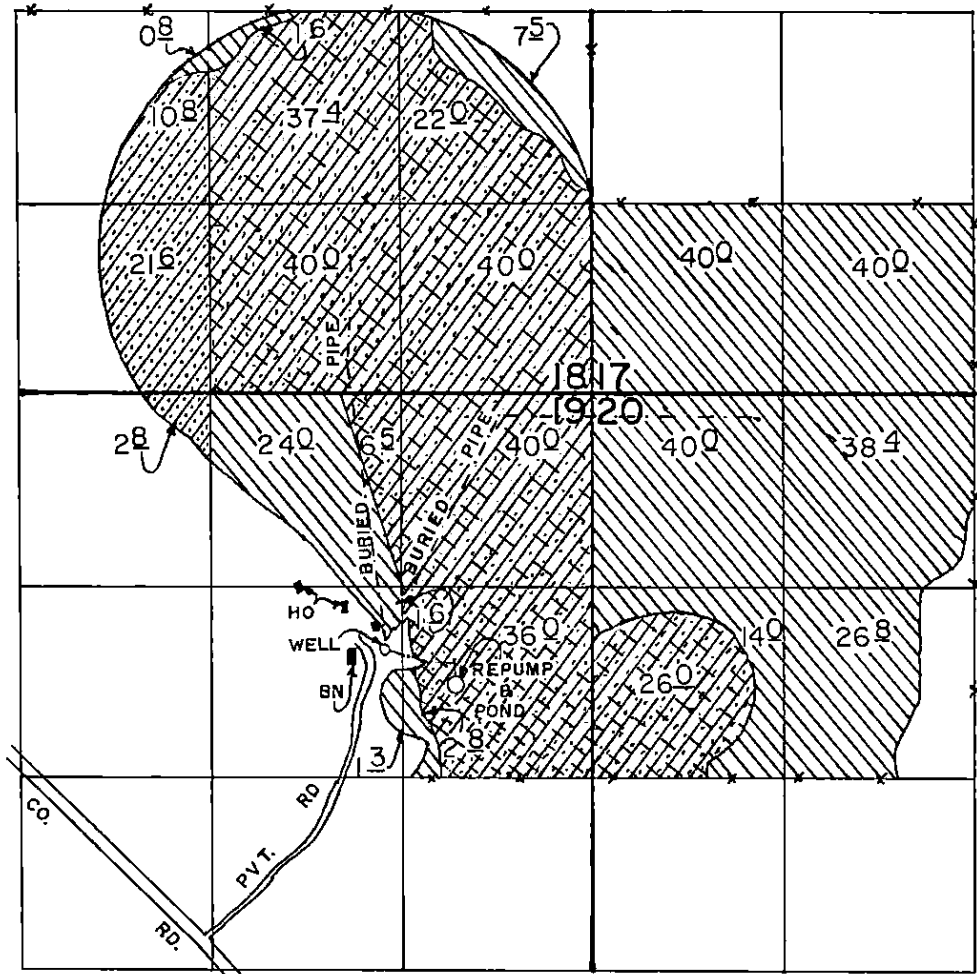

WELL LOC 1750' S & 1430' W FROM NE COR. OF SEC 19.
 REPUMP LOC: 1980' S & 940' W FROM NE COR. OF SEC 19.

SCALE: 1" = 1320'

FINAL PROOF SURVEY

UNDER

G-8012
 G-10134

Application No. G-10850 Permit No. G-9963
 IN NAME OF

G-7542
 G-9240



PRIORITY DATES

APRIL 11, 1977 SUPPLEMENTAL
 FEBRUARY 3, 1981 PRIMARY
 DECEMBER 6, 1982 PRIMARY

GRANT F. BROWN

Surveyed JULY 28, 1994, by R.M.SUTTERFIELD