


T23S R34E, WM
HARNEY COUNTY, OREGON


RECEIVED
 OCT 30 2019
 OWRD



- Well & Meter
- Well
- Meter for Well #10
- POU IR
- Township
- Section
- Quarter Quarter
- Tax Lot

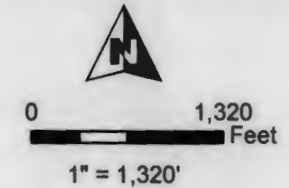

RENEWAL DATE 12/31/2020

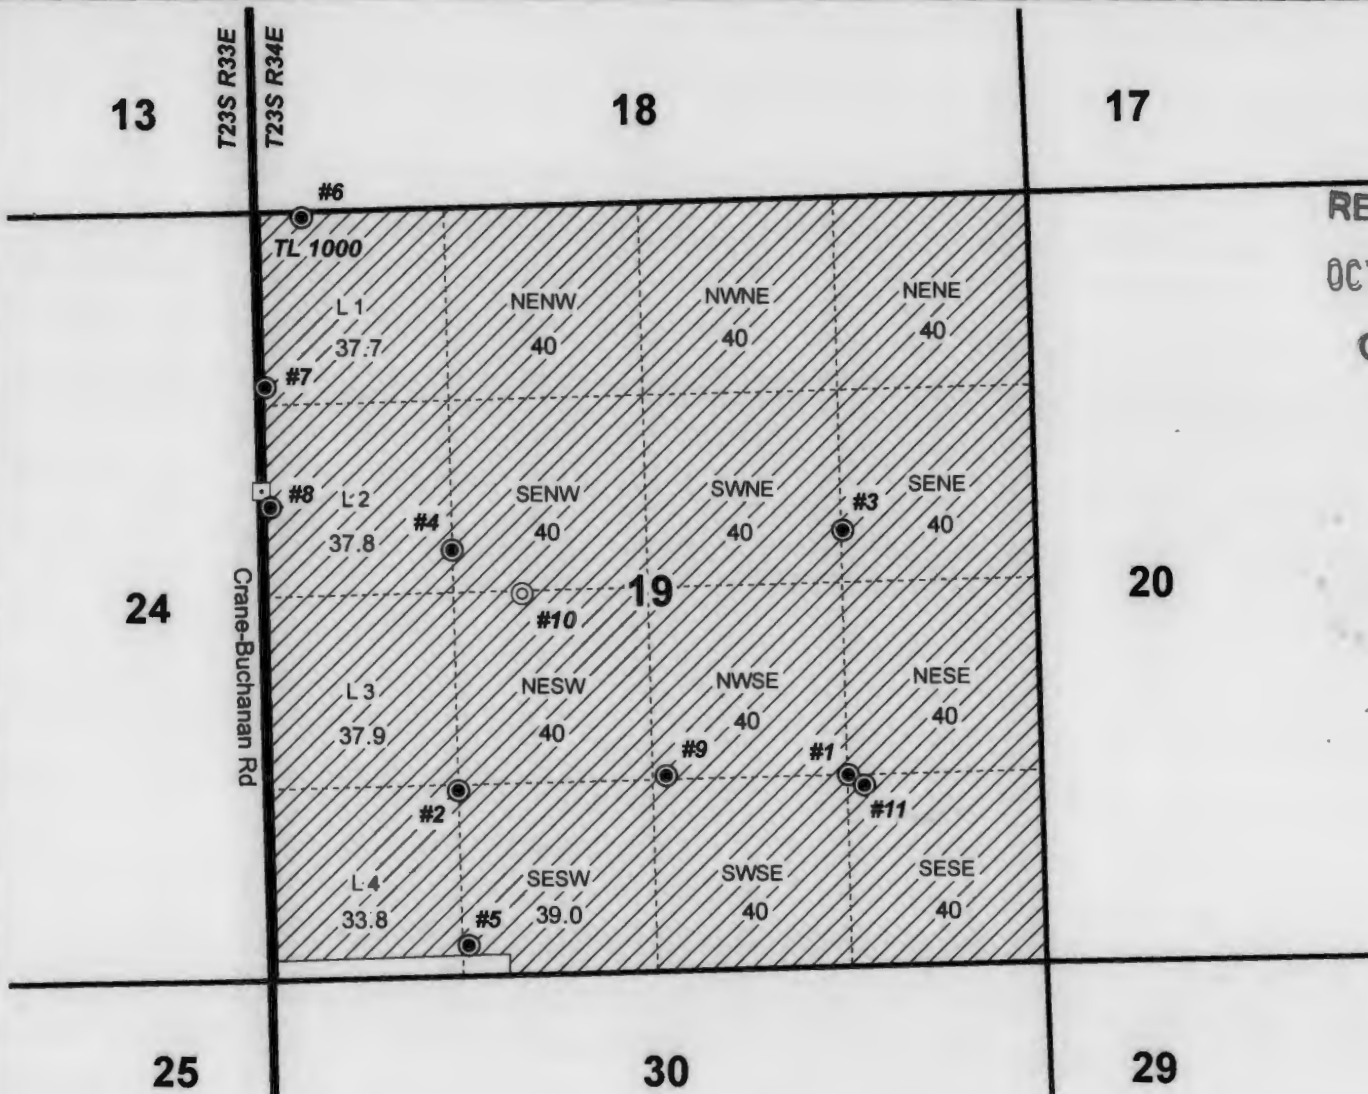

WELL LOCATIONS:

#1 (HARN 735): 1,320' N, 1,320' W OF SE COR SEC 19
 #2 (HARN 732): 1,320' N, 1,300' E OF SW COR SEC 19
 #3 (HARN 733): 2,320' S, 1,320' W OF NE COR SEC 19
 #4 (HARN 734): 2,300' S, 1,320' E OF NW COR SEC 19
 #5 (HARN 52174/L-116138): 250' N, 1,340' E OF SW COR SEC 19

#6 (HARN 52186/L-116149): 30' S, 330' E OF NW COR SEC 19
 #7 (HARN 52447/L-118166): 1,200' S, 70' E OF NW COR SEC 19
 #8 (HARN 52173/L-116136): 2,010' S, 110' E OF NW COR SEC 19
 #9 (HARN 731): 1,420' N, 2,690' E OF SW COR SEC 19
 #10 (HARN 52218/L-118159): 2,670' N, 1,710' E OF SW COR SEC 19
 #11 (HARN 52274/L-118163): 1,220' N, 1,250' W OF SE COR SEC 19

CLAIM OF BENEFICIAL USE MAP
TOR S FARMS, LLC

T-12655

NOTE: THIS MAP IS NOT INTENDED TO
 PROVIDE LEGAL DIMENSIONS OR LOCATIONS
 OF PROPERTY OWNERSHIP LINES.

Date: 10/26/2019

WATER RIGHT SERVICES, LLC
 PO BOX 1830, BEND, OR 97709
 CCB# 197121 www.oregonwater.us
 541-389-2837 JOHNSHORT@USA.COM