


T. 7S. R2W., W.M.


Marvin L. Turner

SECTION 25
MARION COUNTY
9120 ALASKA ST SE
SALEM, OR. 97301

PREPARATION OF THIS MAP IS
FOR THE PURPOSE OF
IDENTIFYING THE LOCATION OF
THE WATER RIGHT ONLY. THERE
IS NO INTENT TO PROVIDE
DIMENSIONS OR LOCATION OF
PROPERTY OWNERSHIP LINES.

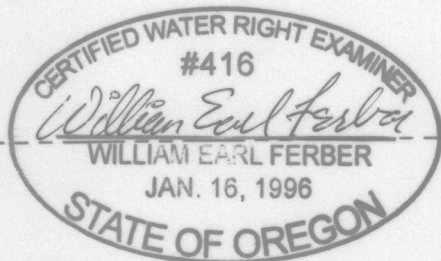

EXPIRES: 2017.12.31

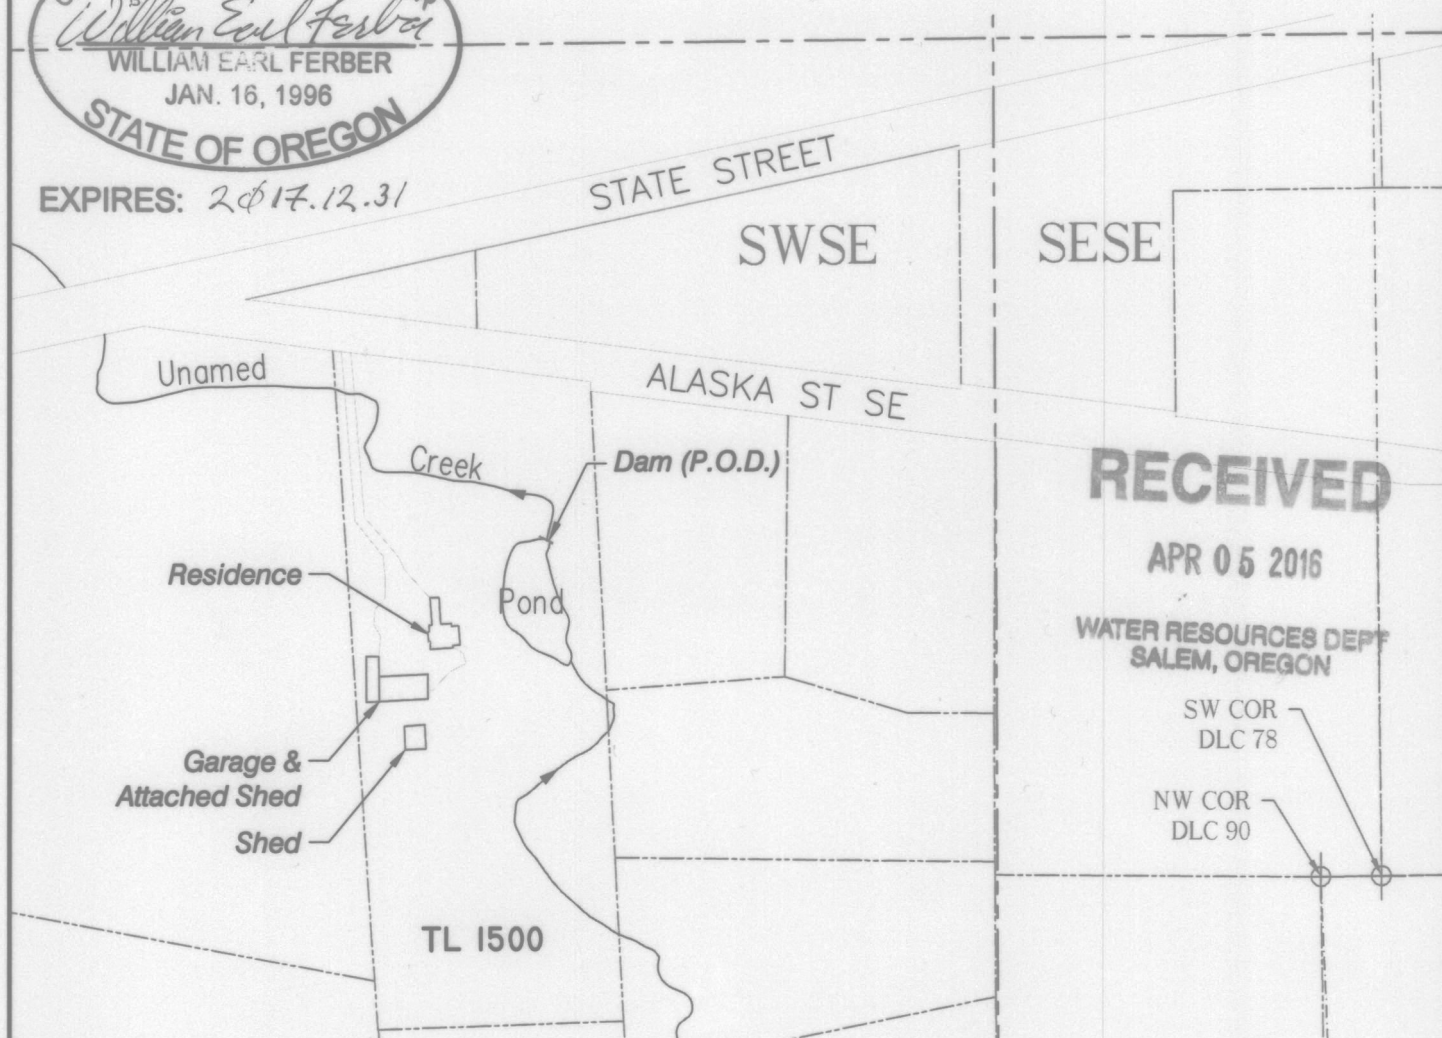

RECEIVED

APR 05 2016


WATER RESOURCES DEPT
SALEM, OREGON

NOTES:

LOCATION OF DAM (P.O.D.) IS 348 FEET NORTH AND
813 FEET WEST OF THE NW COR OF DLC #90.
GPS COORDINATES ARE 44°55'41" N AND 122°52'25" W.

Survey

AND CLAIM OF BENEFICIAL USE UNDER
APPLICATION No. S-72449
PERMIT No. S-52458
IN THE NAME OF MARVIN L. TURNER

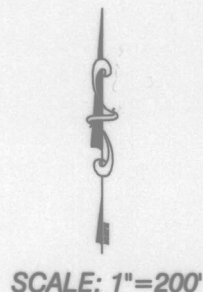

LEGEND

---	PROPERTY LINE
- - -	USGS GRID
- . - . -	DLC BOUNDARY
---	ROADWAY
---	STRUCTURE
---	WATER
⊕	DLC CORNER

FILE PATH & NAME: C:\BK\TURNER\TURNER 111315.dwg

BK WATER RIGHT CONSULTING
PO Box 13434 Salem, Oregon 97309

Turner Water Right

APPLICATION#: S-72449 PERMIT#: S-52458 AMENDMENT#: X-XXXXX

SHEET 1 OF 1