

CLAIM OF BENEFICIAL USE MAP

SECTION 21, MAP 6N 6W TAX LOT 100
CLATSOP COUNTY, OREGON
APPLICATION 83785 PERMIT S- 53505


PREPARED FOR
MATT ARMSTRONG
86340 NORTHRUP CREEK RD
BIRKENFELD, OR 97016



1 inch = 400 ft.


LEGEND

- PROPERTY BOUNDARY LINE
- - - - - 1/16TH SECTION LINE

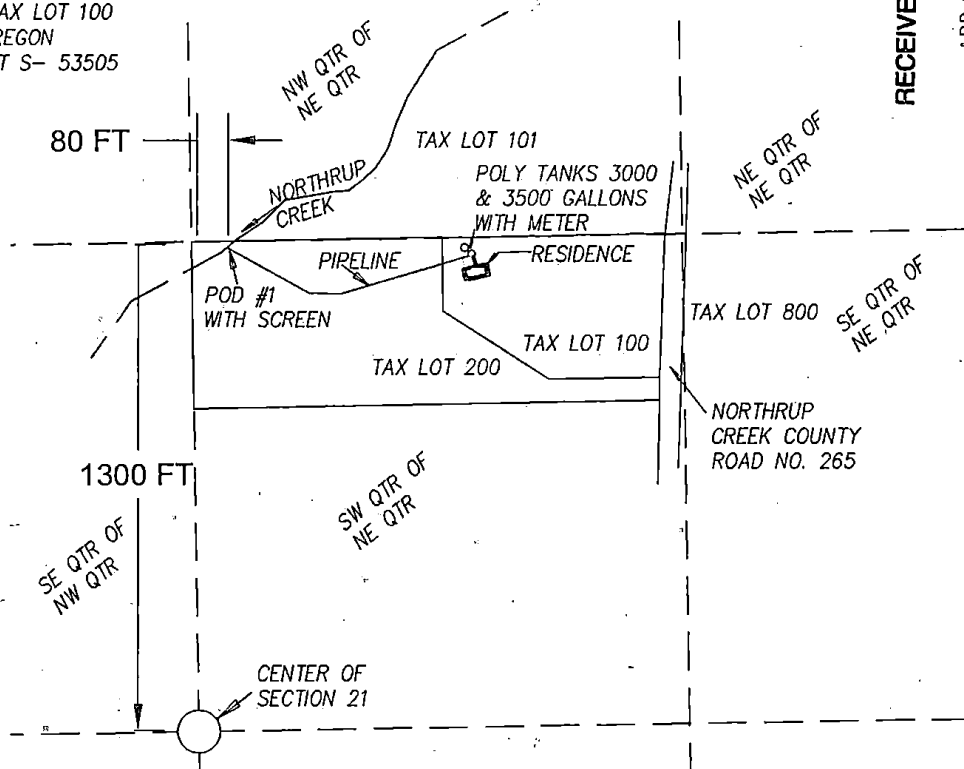

MAP BASES: CLATSOP COUNTY TAX MAP T6N
R6W SEC. 21
2015 AERIAL PHOTO FROM GOOGLE EARTH.

THIS MAP WAS PREPARED FOR THE PURPOSE OF
IDENTIFYING THE LOCATION OF A WATER RIGHT
ONLY AND IS NOT INTENDED TO PROVIDE LEGAL
DIMENSIONS OR LOCATION OF PROPERTY
OWNERSHIP LINES.

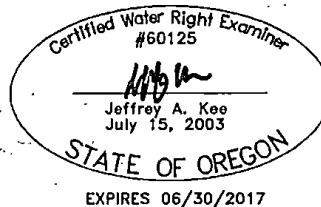

Stuntzner
Engineering
& Forestry, LLC

Project: 316-013
By: JEFFREY KEE
Date: APRIL 20, 2016

RECEIVED BY OWRD

APR 29 2016

SALEM, OR