


ACM II Oregon 2, LLC

T8S R1W Sec. 14 & 23

REVISED 6/12/2019 REVISED 7/31/2019

RECEIVED
AUG 05 2019
OWRD

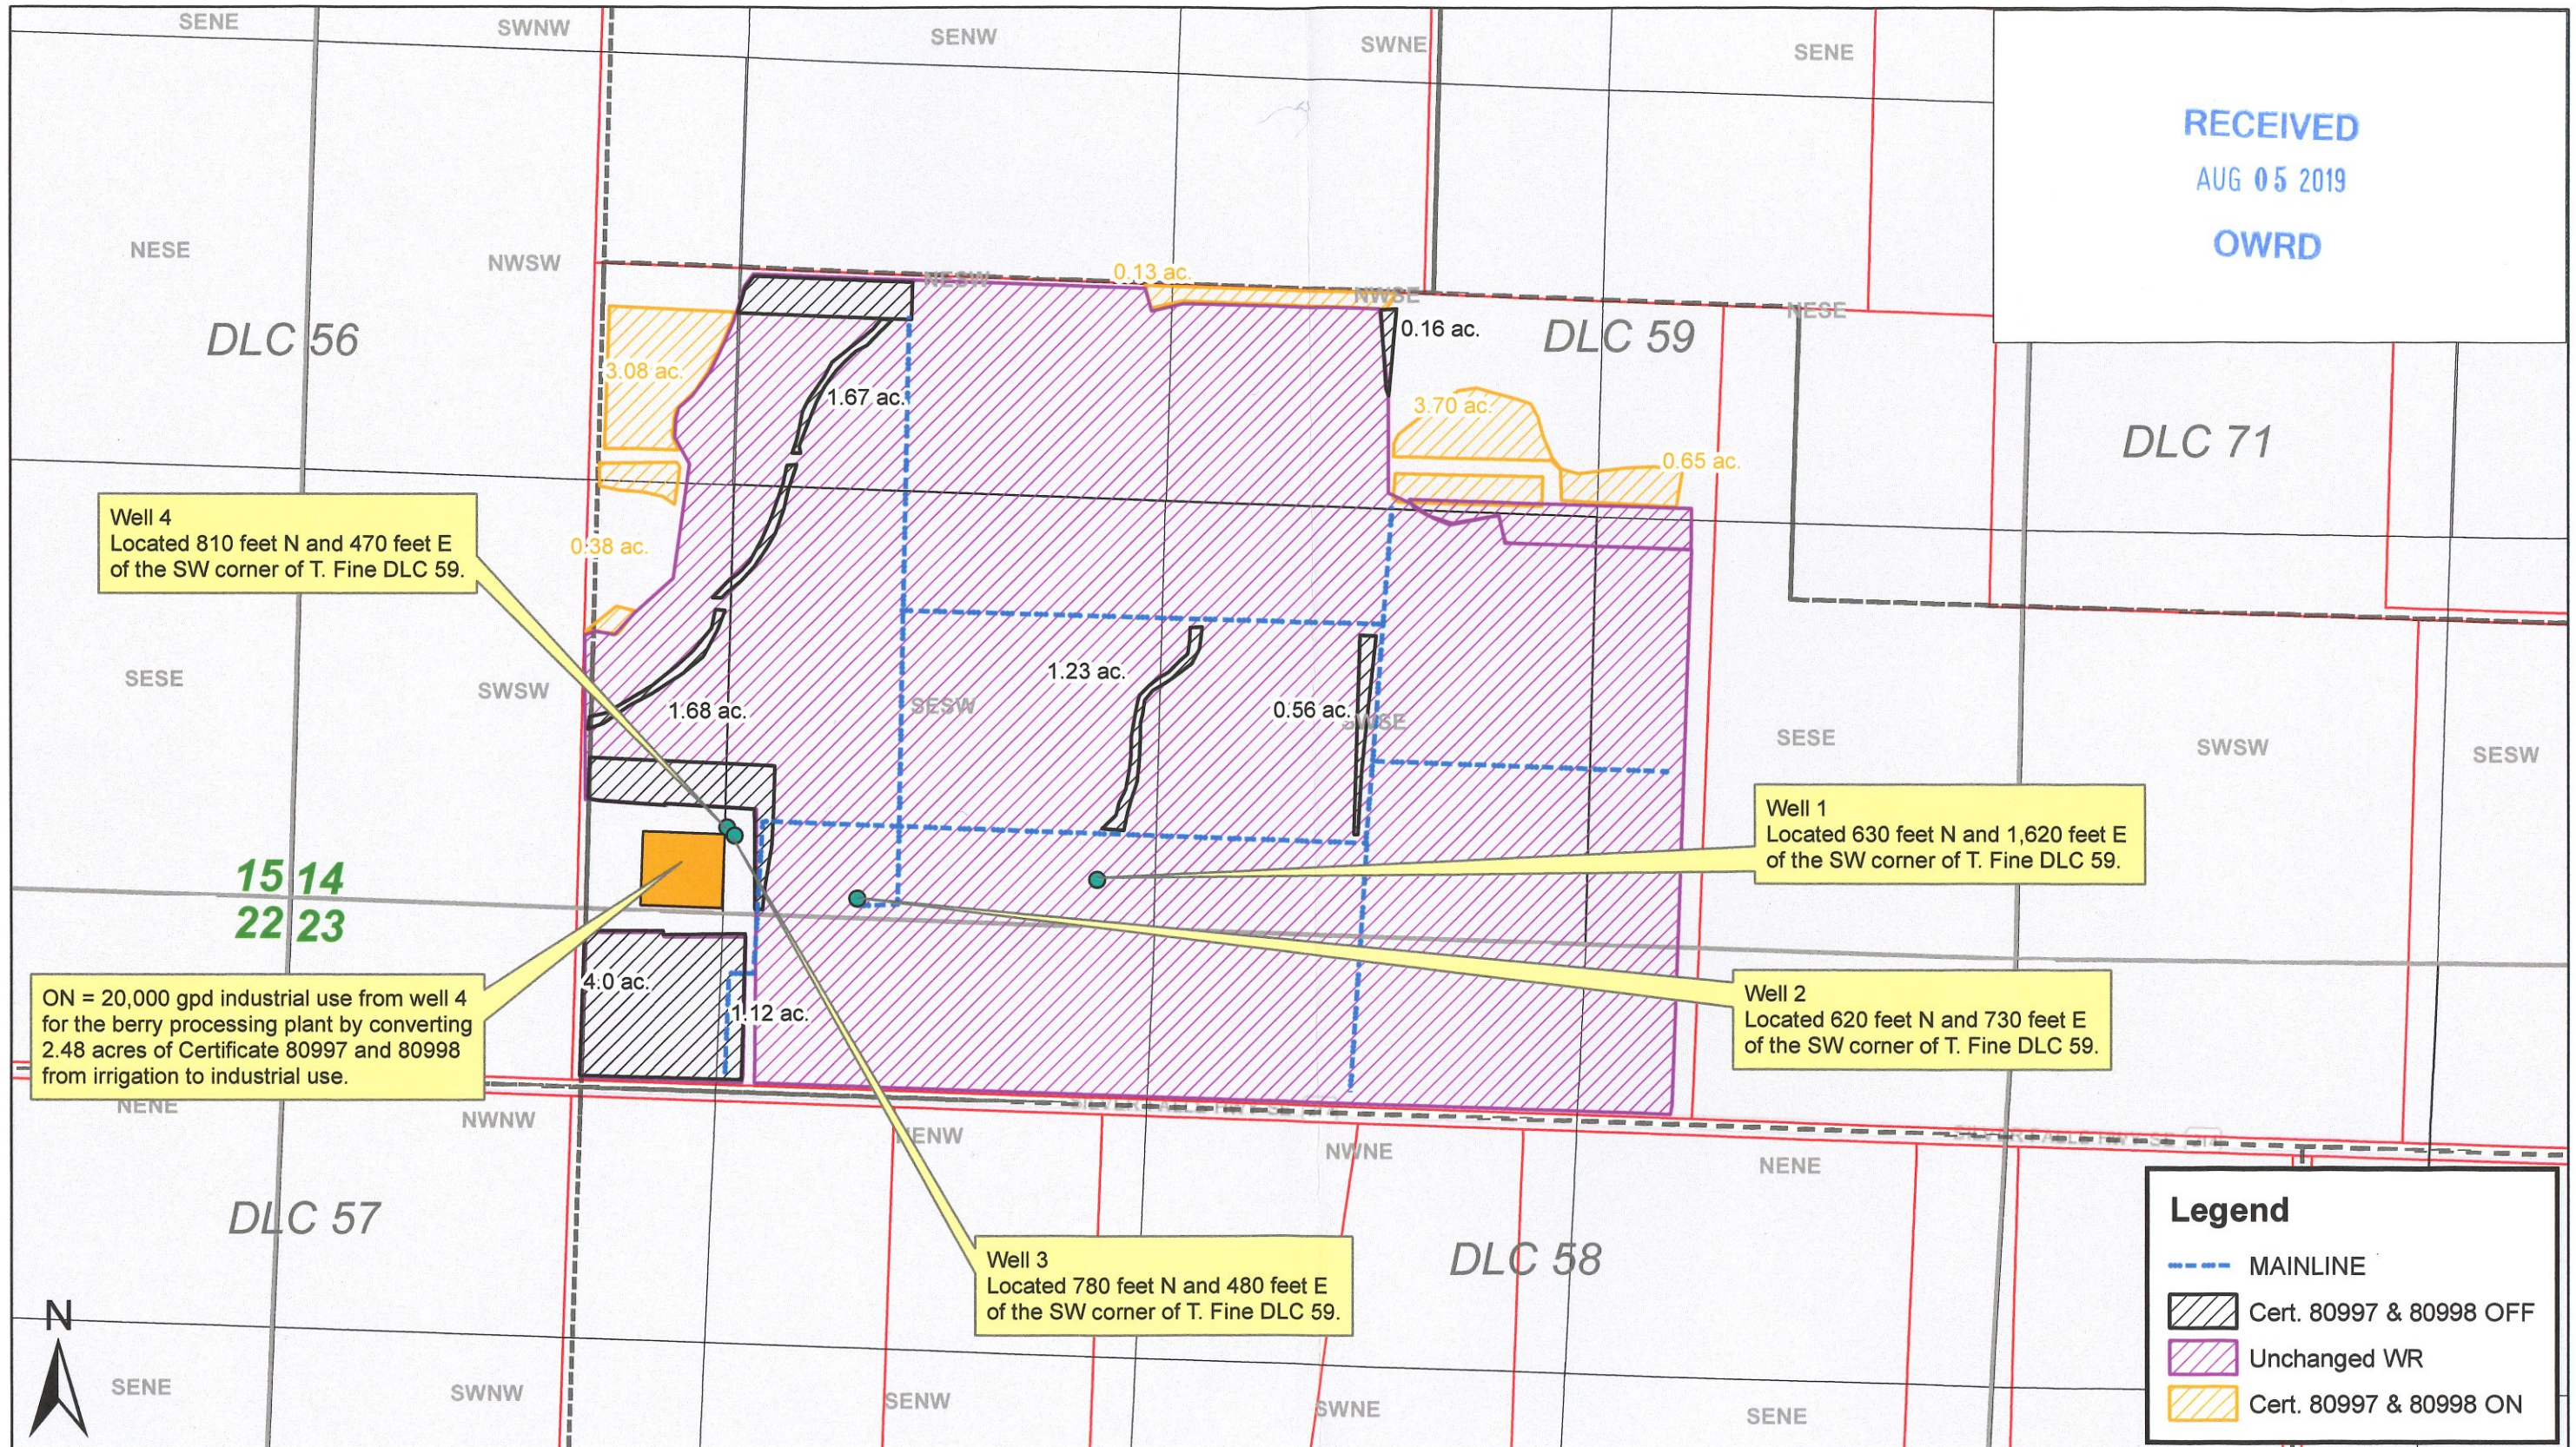


15 14
22 23

Legend

- MAINLINE
- ▨ Cert. 80997 & 80998 OFF
- ▨ Unchanged WR
- ▨ Cert. 80997 & 80998 ON

T.8S. R.1W., W.M.

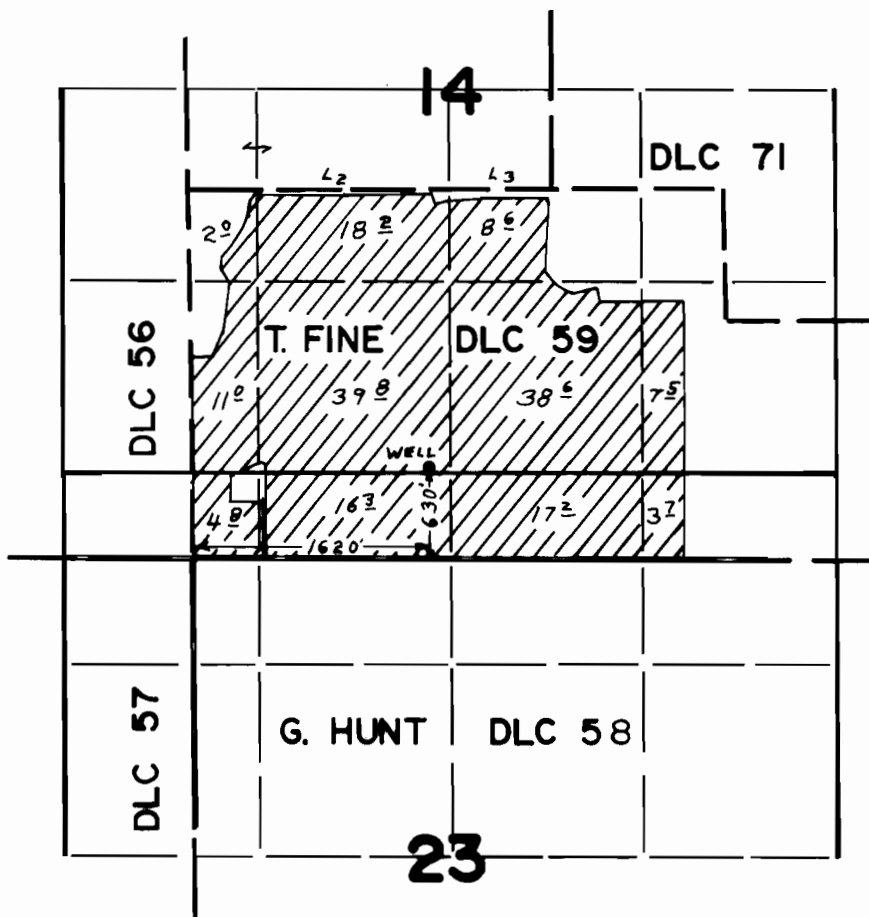

FINAL PROOF SURVEY UNDER

Application No. G-6041... Permit No. G-5718
IN NAME OF

..... TRIUMPH, INC.

Surveyed OCT. 19 1978, by S. P. APPLGATE.