

**T16S R14E,
SECTION 10, WM**

CROOK COUNTY, OREGON




0 400
Feet


1" = 400'

-  POU Irrigation
-  Drip Emitters
-  Section
-  Quarter Quarter
-  Tax lot
-  Well
-  Meter
-  Buried Pipeline

WELL LOCATION:
220' S, 1,040' W OF N 1/4 COR SEC 10

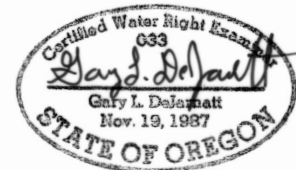

RENEWAL DATE 12/31/2017

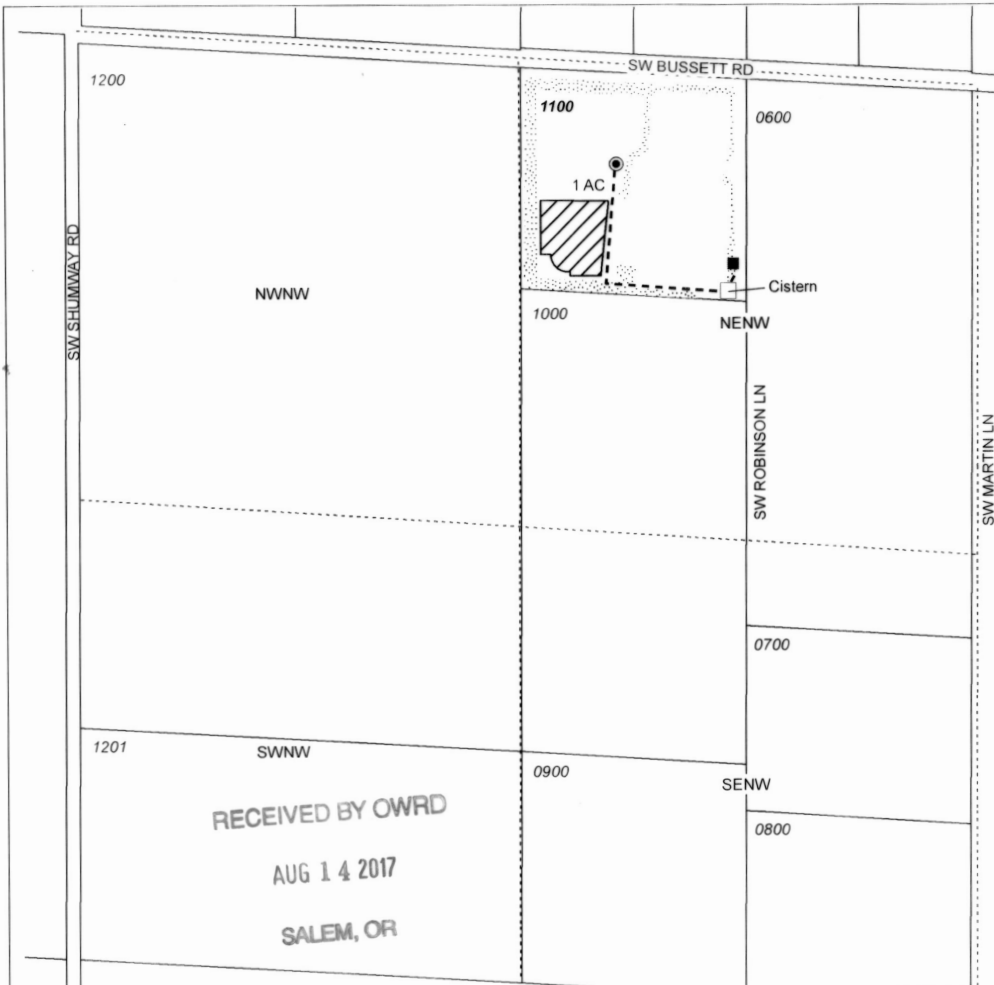

RECEIVED BY OWRD

AUG 14 2017

SALEM, OR

CLAIM OF BENEFICIAL USE

Jon Fields

NOTE: THIS MAP IS NOT INTENDED TO
PROVIDE LEGAL DIMENSIONS OR LOCATIONS
OF PROPERTY OWNERSHIP LINES.

WATER RIGHT SERVICES, LLC

PO BOX 1830, BEND, OR 97709

CCB# 197121 www.oregonwater.us

541-389-2837 JOHNSHORT@USA.COM

AP G-16526

PERMIT G-16219

PROJECT #17008

JULY 21, 2017