


T24S, R35E, W.M.
Harney County, Oregon

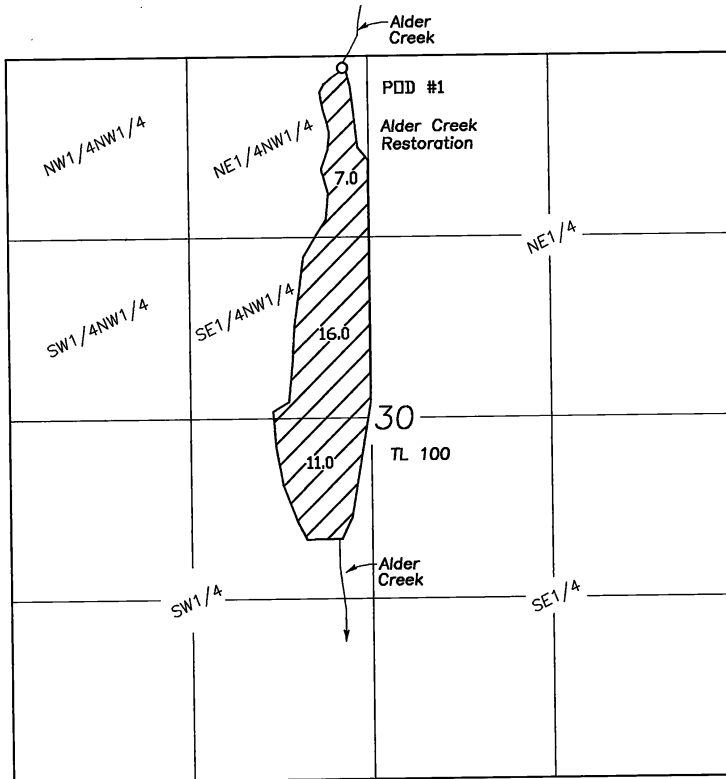

POD#1 is located 85' South & 2458' East of the NW corner of Section 30.

RECEIVED

AUG 08 2019

OWRD



SCALE 1"=1320'

FINAL PROOF SURVEY
CLAIM OF BENEFICIAL USE
CHANGE CHARACTER OF USE
ALDER CREEK RESTORATION

For

Bureau of Land Management

June 18, 2019

LEGEND

Application No. T-12157

A portion of Tax Lot
24-35 TL100

NOTE: Tax Lot 100 is owned by the BLM
and is more than 10,000 acres.
No boundaries of the tax lot
can be shown.

NOTE: The preparation of this map
was for the purpose of identifying
the location of the proposed water
right and has no intent to provide
dimensions or location of property
ownership lines.

RECEIVED

AUG 23 2019

OWRD

Prepared by
Cornerstone Surveying, Inc

P.O. BOX 33
JOHN DAY, OR. 97845
(541)575-1813
jwsurvey55@gmail.com

