


1,320 660 0 1,320
Feet

1" = 1320'



WHEELER COUNTY, OREGON

T 10 S, R 23 E, WM SECTIONS 5 & 8

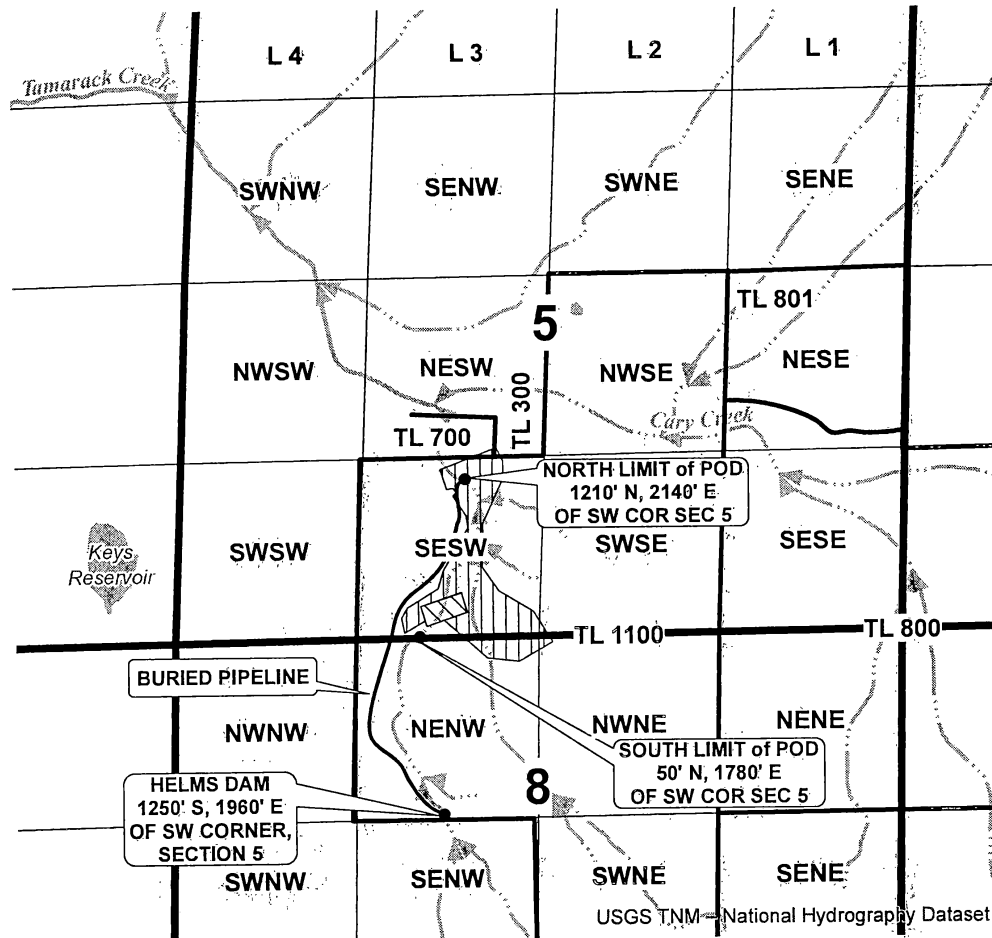

PROPERTY BOUNDARIES

SECTIONS

PLACES OF USE

CERTIFICATE

1887 1.3 AC

OCT 8, 1974

NESW TL 300 0.1 AC

TL 700 0.2 AC

SESW 11.4 AC


SWSE 0.2 AC

SECTION 5

NENW 1.3 AC

NWNE 0.3 AC

SECTION 8

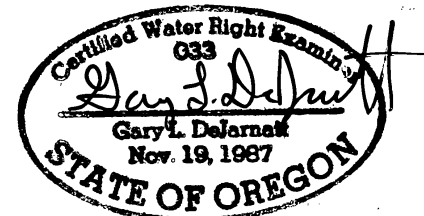

RENEWAL DATE 12-31-2015



**CLAIM OF BENEFICIAL USE MAP
FOR ROBERT & SHARILYN HELMS
T-11735**

NOTE: THIS MAP IS NOT INTENDED TO
PROVIDE LEGAL DIMENSIONS OR LOCATIONS
OF PROPERTY OWNERSHIP LINES.

PROJECT # 15077

OCT 23, 2015

WATER RIGHT SERVICES, LLC
PO BOX 1830, BEND, OR 97709
CCB # 197121 OREGONWATER.US
541-389-2837 JOHNSHORT@USA.COM