


T. 12 S., R. 5 W., W. M.

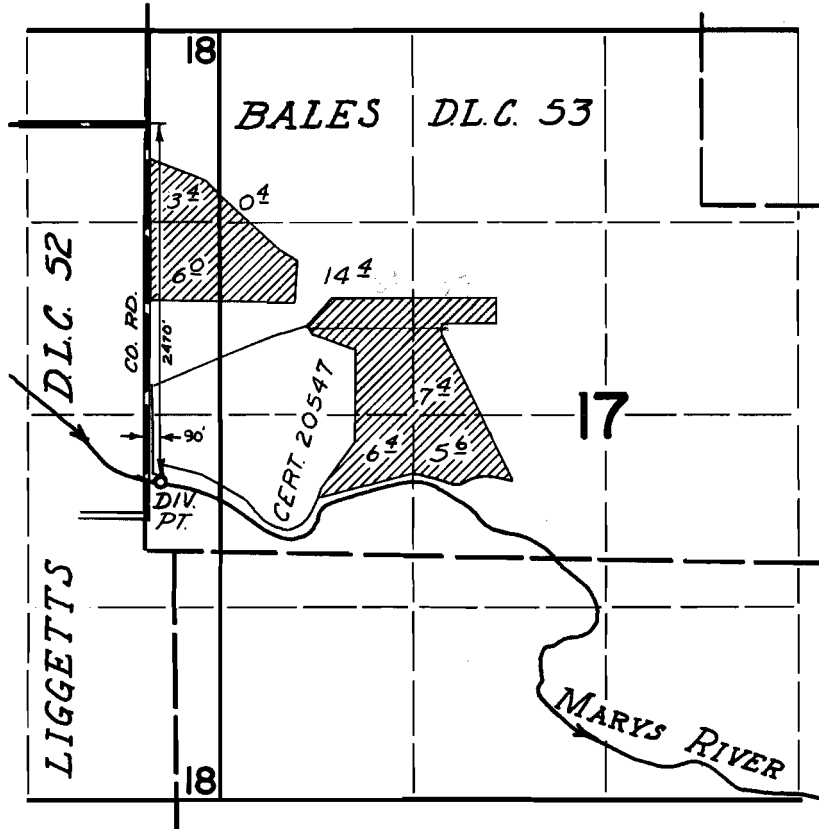

**FINAL PROOF SURVEY**  
UNDER


Application No. 44482 Permit No. 33269  
IN NAME OF

C. W. MANN

Surveyed March 27 1973, by D. Noesby

RECEIVED  
MAY 14 2019  
OWRD

Sections 17, 18 & 20, T12S, R5W, W.M.,  
Benton County, Oregon  
TRANSFER MAP  
Certificate 41818  
Brooks Farm LLC

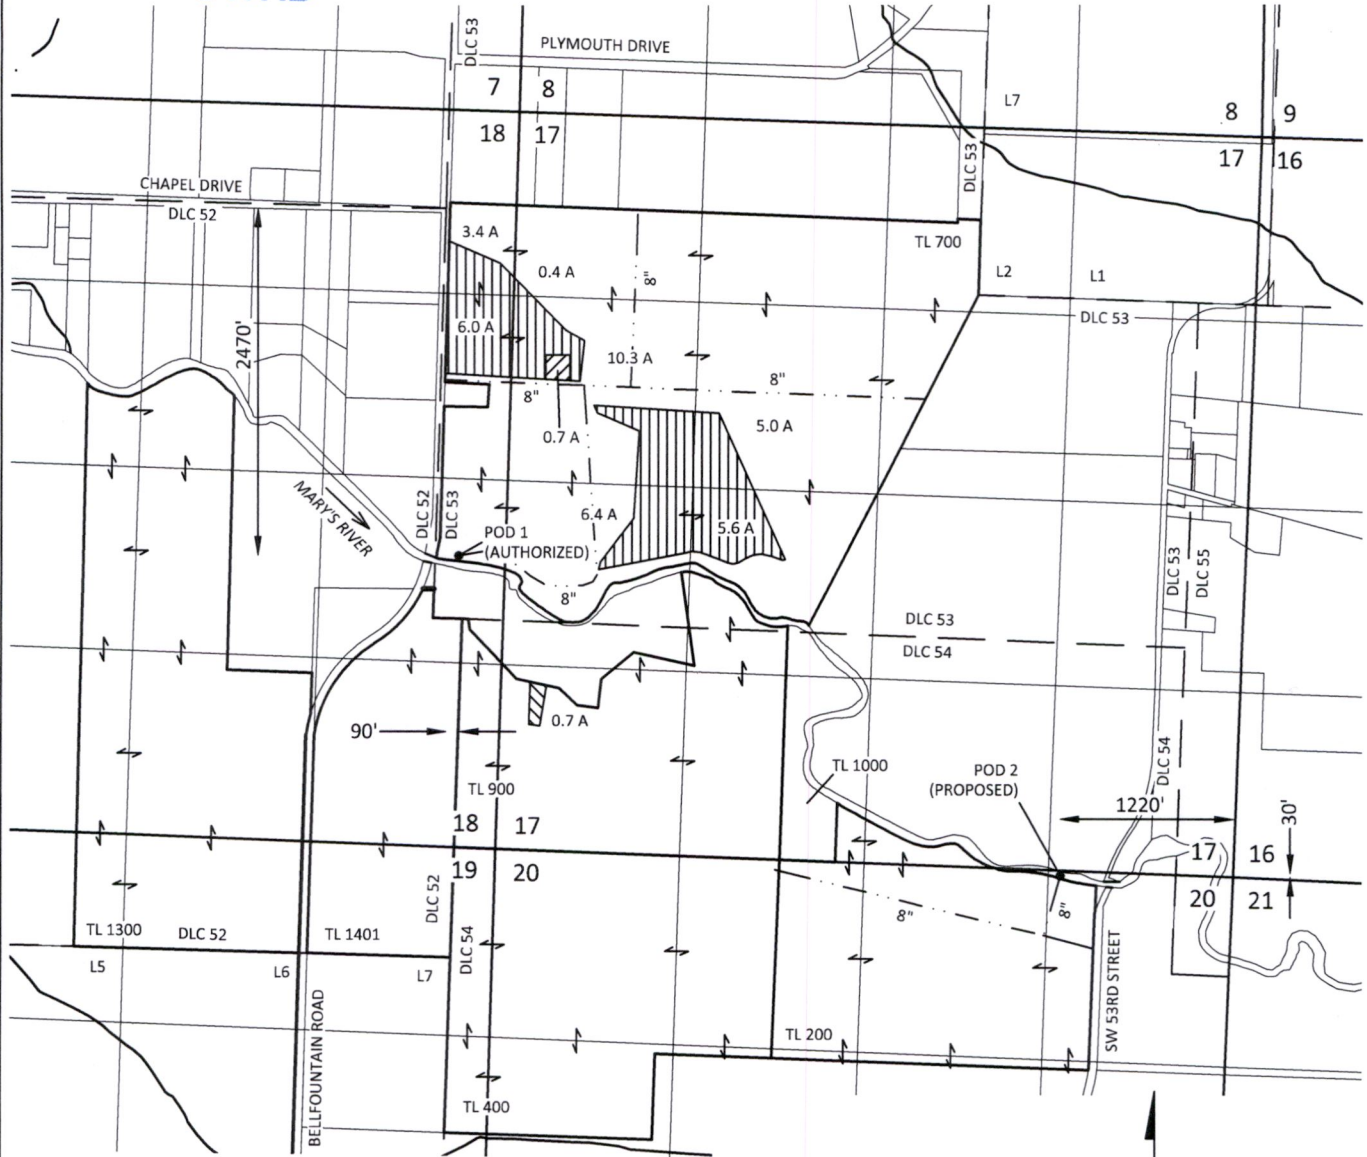

DRAFT

**SKOOKUM**  
WATER ASSOCIATES INC

1626 VICTORIAN WAY  
EUGENE, OR 97401  
(503) 319-8926


EXPLANATION  
FROM LANDS

 CERTIFICATE 41818  
PRIORITY: FEBRUARY 14, 1968  
0.7 ACRES

TO LANDS

 CERTIFICATE 41818  
PRIORITY: FEBRUARY 14, 1968  
0.7 ACRES


REMAINING RIGHTS

 CERTIFICATE 41818  
PRIORITY: FEBRUARY 14, 1968  
37.1 ACRES

• POINT OF DIVERSION (POD)

N

SCALE

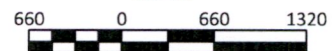

1 INCH = 1320 FEET

May 7, 2019

This map is not intended to provide legal  
dimensions or locations of property  
ownership lines

Figure 1