


T. 12S., R. 5W., W.M.

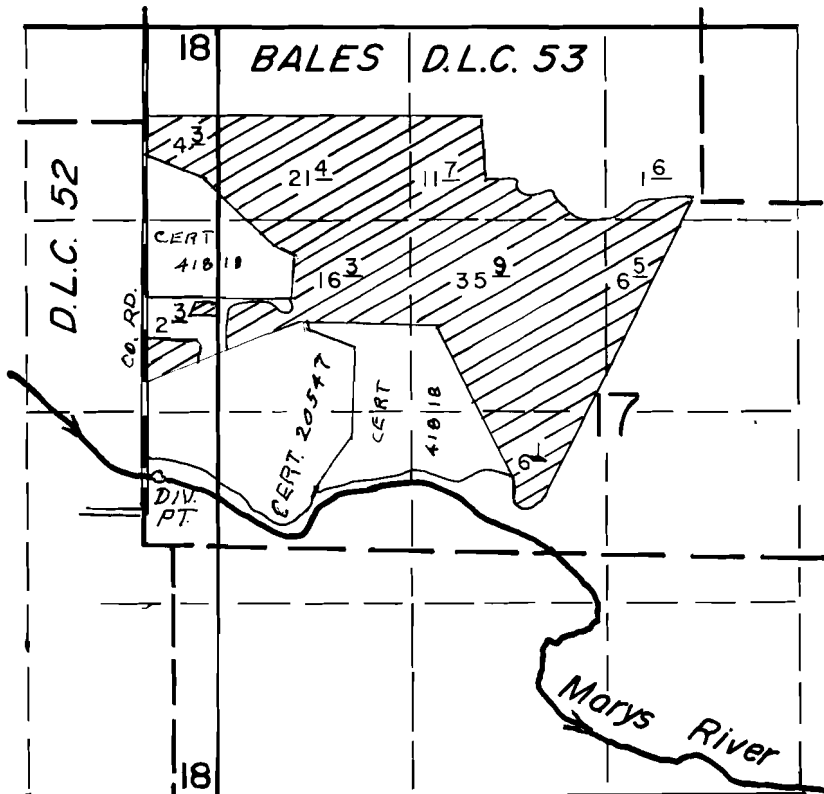

DIV. PT. LOC 2470' FEET SOUTH & 90' FEET EAST, N.E. COR. DLC 52

SCALE: 1" = 1320'

FINAL PROOF SURVEY UNDER


Application No. **58533**.. Permit No. **44194**.....
IN NAME OF

CROCKER FARMS

Surveyed **MAY 5**..... **1987**., by **T.M. WARREN**.....

Sections 17, 18 & 20, T12S, R5W, W.M.,
 Benton County, Oregon
TRANSFER MAP
 Certificate 61593
 Brooks Farm LLC

RECEIVED
 MAY 14 2019
OWRD

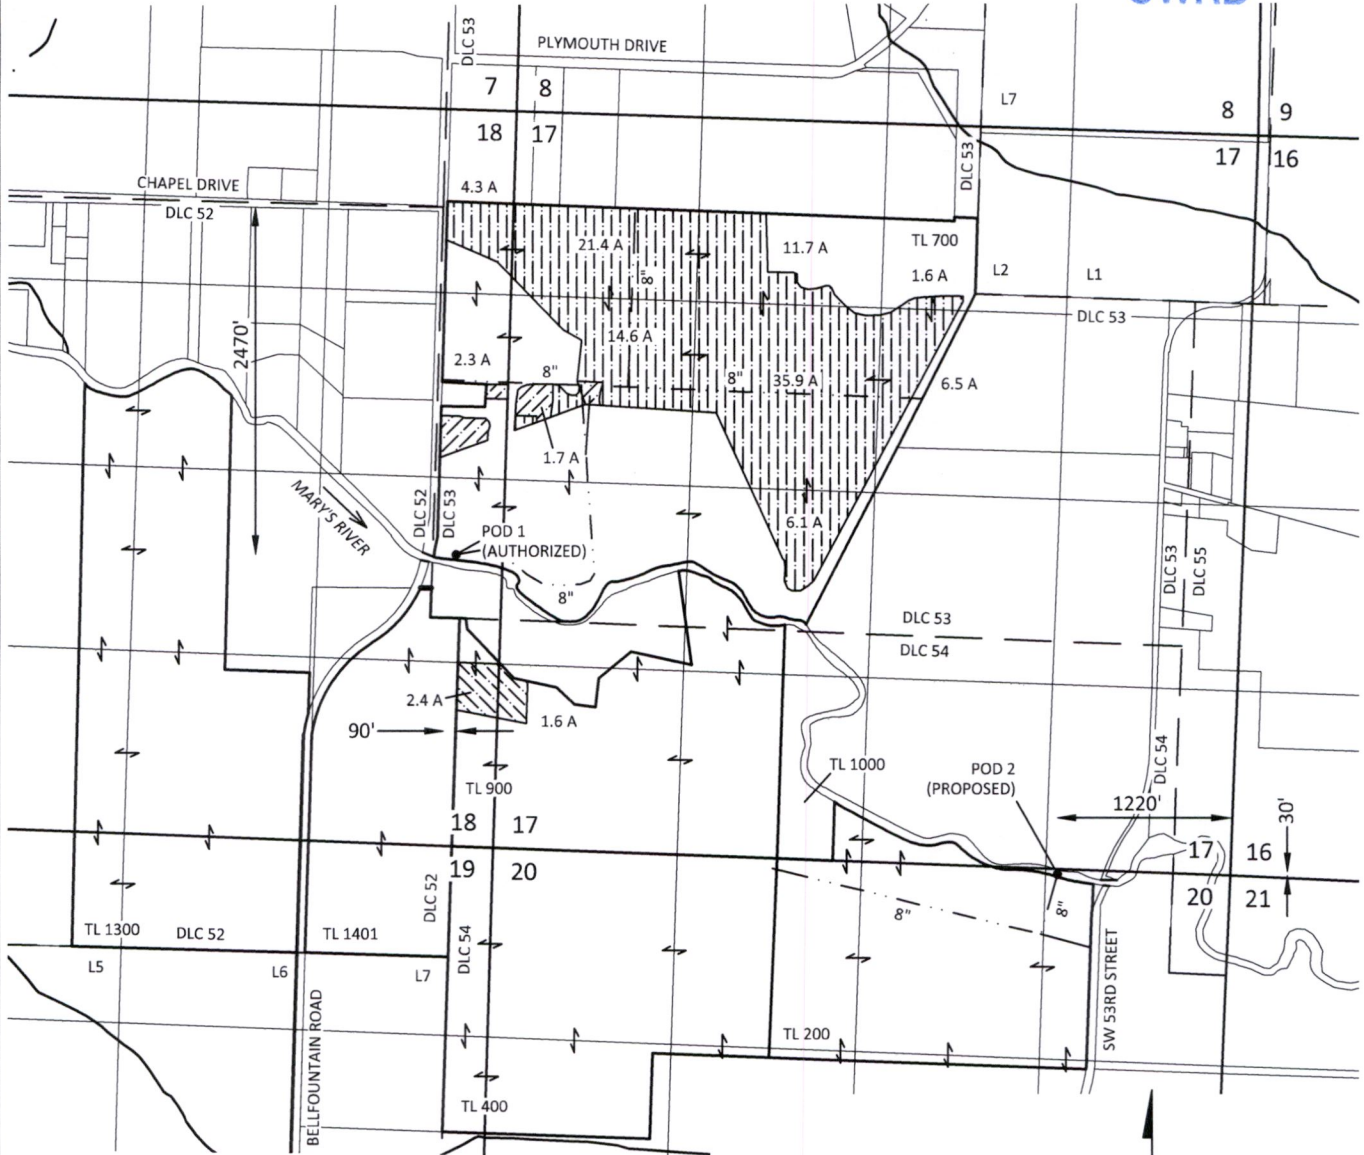

DRAFT

SKOOKUM
 WATER ASSOCIATES INC

1626 VICTORIAN WAY
 EUGENE, OR 97401
 (503) 319-8926


**EXPLANATION
 FROM LANDS**

 CERTIFICATE 61593
 PRIORITY: APRIL 16, 1979
 4.0 ACRES


TO LANDS

 CERTIFICATE 61593
 PRIORITY: APRIL 16, 1979
 4.0 ACRES

REMAINING RIGHTS

 CERTIFICATE 61593
 PRIORITY: APRIL 16, 1979
 102.1 ACRES

• POINT OF DIVERSION (POD)

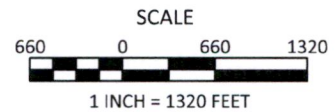

May 7, 2019

This map is not intended to provide legal
 dimensions or locations of property
 ownership lines

Figure 4