



FINAL PROOF MAP

TO TRANSFER RIGHTS AND
CHANGE POINT OF APPROPRIATION
FOR T-11162
HUFFORD ESTATE, LLC

TOWNSHIP 25 SOUTH, RANGE 14 EAST, SECTION 23, W.M.
TAX LOT: 400

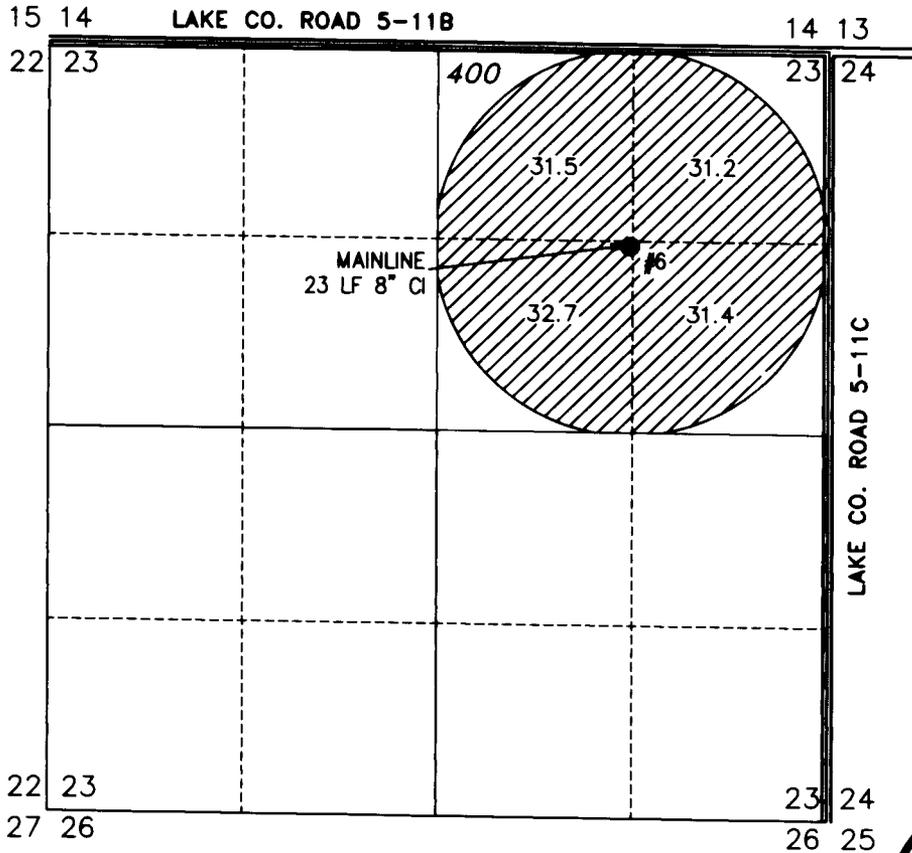

 126.8 ACRES FROM G-9348
(CERT.# 52626)
TRANSFERRED, AS SHOWN

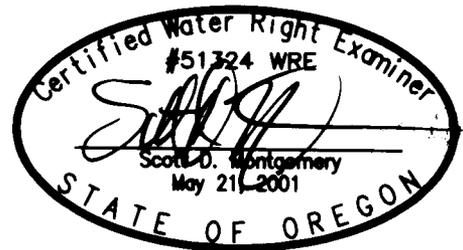

RENEWAL DATE: 12/31/2016

● **WELL 6 (LAKE 52251)**

NEW WELL IN THE SW 1/4 OF THE NE 1/4 OF SECTION 23 LOCATED 1295 FEET NORTH AND 1382 FEET WEST FROM THE EAST 1/4 CORNER OF SECTION 23, TOWNSHIP 25 SOUTH, RANGE 14 EAST, W.M., LAKE COUNTY, OREGON

NEWLY INSTALLED METER IS APPROXIMATELY 15.0 FEET EAST ALONG DELIVERY PIPE FROM WELL.

THIS MAP IS FOR THE PURPOSE OF LOCATING A WATER RIGHT ONLY AND HAS NO INTENT TO PROVIDE LEGAL DIMENSIONS OR THE LOCATION OF PROPERTY LINES

PREPARED FOR:

HUFFORD ESTATE, LLC
P.O. BOX 99
FORT ROCK, OR 97735


PREPARED BY:



ALL POINTS ENGINEERING AND SURVEYING, INC.
P.O. BOX 767
TERREBONNE, OR 97760
(541) 548-5833
www.APEandS.com

TRANSFER MAP TO ACCOMPANY
APPLICATION TO CHANGE POINT OF
APPROPRIATION AND PLACE OF USE
FOR
HUFFORD ESTATE, LLC


"FROM" TAX LOT 400
IN SECTION 23, TOWNSHIP 25 SOUTH, RANGE 14 EAST, W.M.
LAKE COUNTY, OREGON

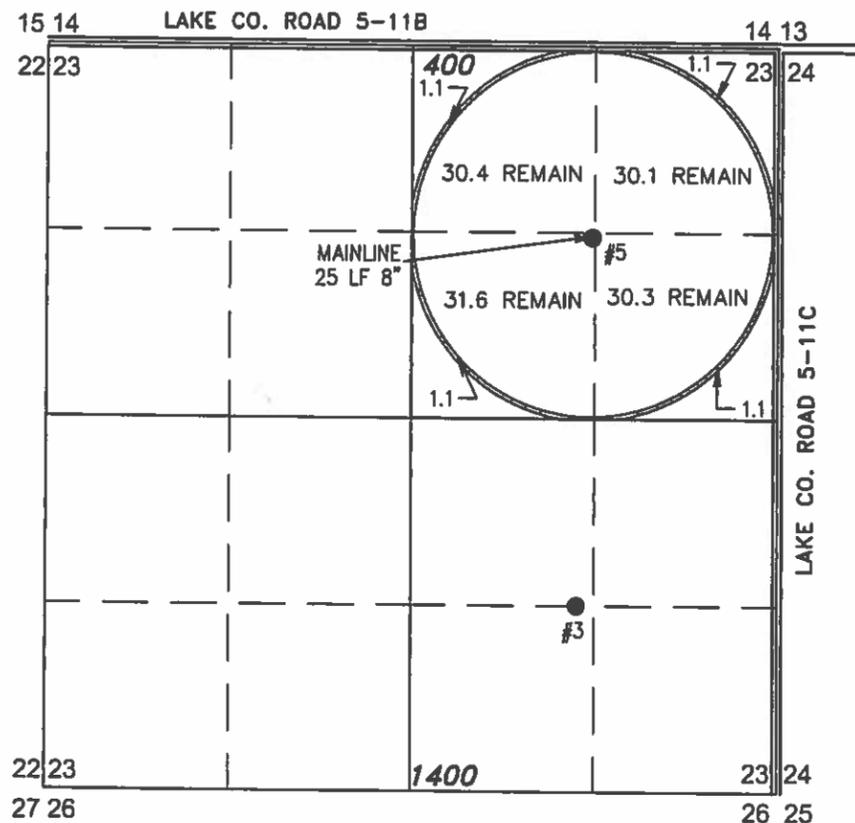

THIS MAP IS FOR THE PURPOSE OF LOCATING A
WATER RIGHT ONLY AND HAS NO INTENT TO
PROVIDE LEGAL DIMENSIONS OR THE LOCATION OF
PROPERTY LINES.

"LX" = GOVERNMENT LOT X

"TO" TAX LOTS 600
IN SECTION 19, TOWNSHIP 25 SOUTH, RANGE 15 EAST, W.M.
LAKE COUNTY, OREGON

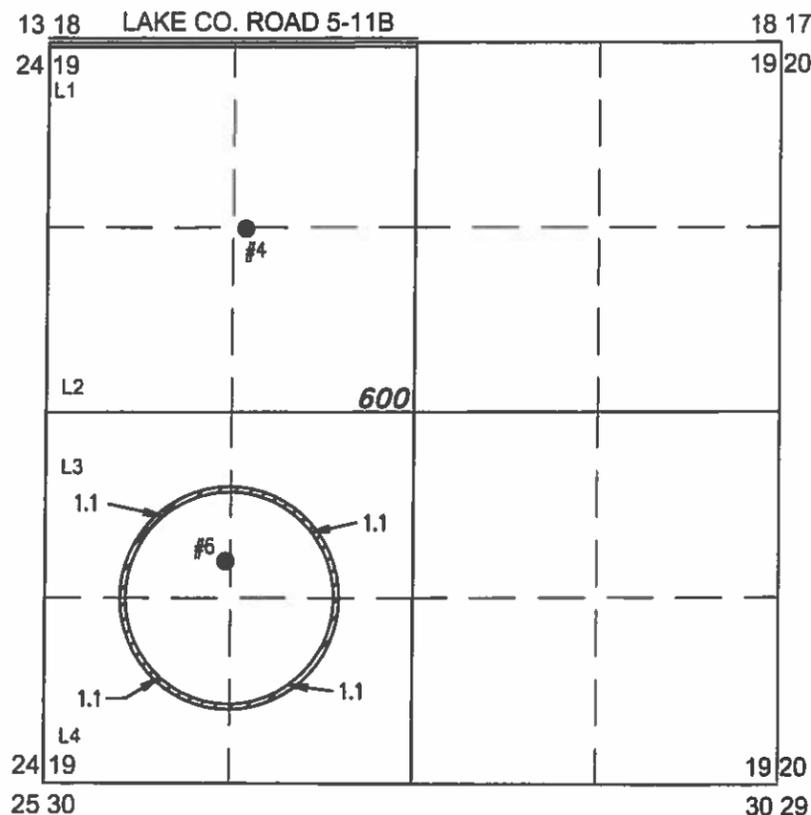


WELL #6 (LAKE 170/174) LOCATED IN THE NW 1/4 SW 1/4 SECTION 19, T25S R15E,
W.M. LOCATED 3700 FEET SOUTH AND 1310 FEET EAST FROM THE NW CORNER
OF SECTION 19.



4.4 ACRES WATER RIGHTS TRANSFERRED FROM
CERTIFICATE #90486 (G-9348) 122.4 ACRES REMAIN,
AS SHOWN. PRIORITY DATE 4/28/1981.



4.4 ACRES WATER RIGHTS TRANSFERRED FROM
CERTIFICATE #90486 (G-9348) 122.4 ACRES REMAIN,
AS SHOWN. PRIORITY DATE 4/28/1981.

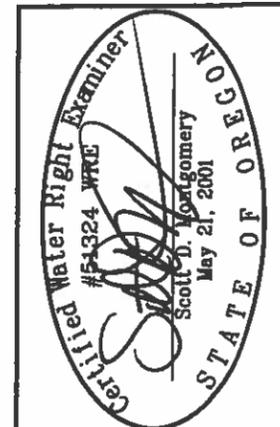

ALL POINTS ENGINEERING
& SURVEYING, INC.

P.O. BOX 767
TERREBONNE, OREGON 97760
(541) 548-5833 PH
Scott@APEandS.com
www.APEandS.com



PROJECT No. 14-120

PREPARED AT THE REQUEST OF:
HUFFORD ESTATE, LLC
P.O. BOX 99
FORT ROCK, OR 97735

RECEIVED BY OWRD

OCT 24 2016

SALEM, OR

T 12515