



Sections 11 & 14, T13S, R24E, W.M.,  
Wheeler County, Oregon

CLAIM OF BENEFICIAL USE MAP FOR T-12612  
Alscott Antone Ranch LLC

PRIMARY RIGHTS

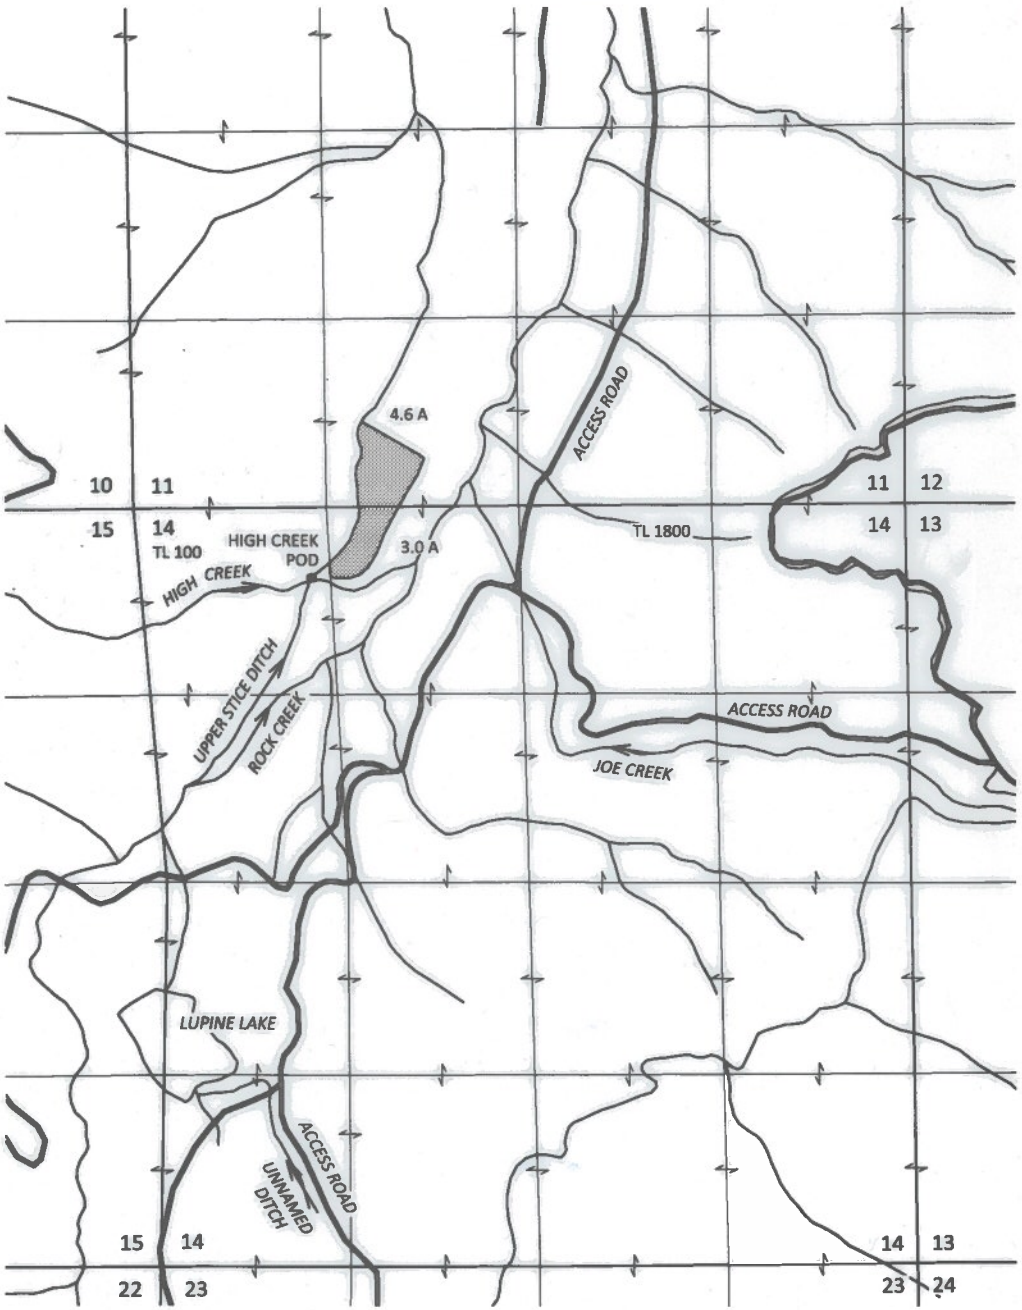

SUPPLEMENTAL RIGHTS

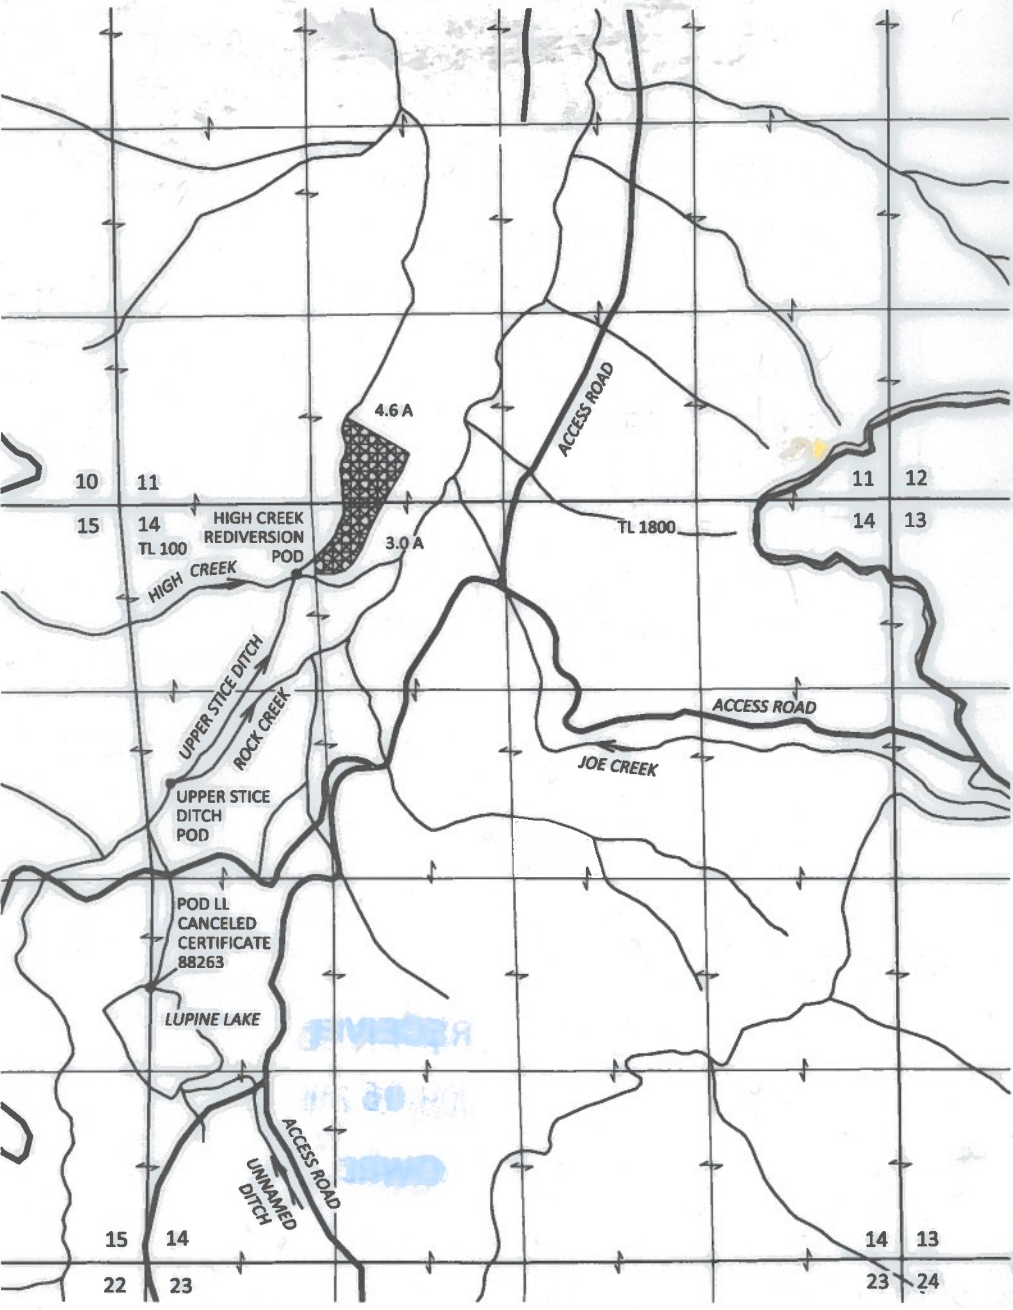

EXPLANATION

PRIMARY IRRIGATION  
CANCELED CERTIFICATE 88259  
PRIORITY: 1887


SUPPLEMENTAL IRRIGATION  
CANCELED CERTIFICATE 88260  
PRIORITY: 1899

SUPPLEMENTAL IRRIGATION  
CANCELED CERTIFICATE 88261  
PRIORITY: 4/30/1954


SUPPLEMENTAL IRRIGATION  
CANCELED CERTIFICATE 88262  
PRIORITY: 10/16/1914

SUPPLEMENTAL IRRIGATION  
CANCELED CERTIFICATE 88263  
PRIORITY: 8/6/1986

POD INSET MAP  
CANCELED CERTIFICATE 88262  
SECTION 16, T13S, R24E, W.M.

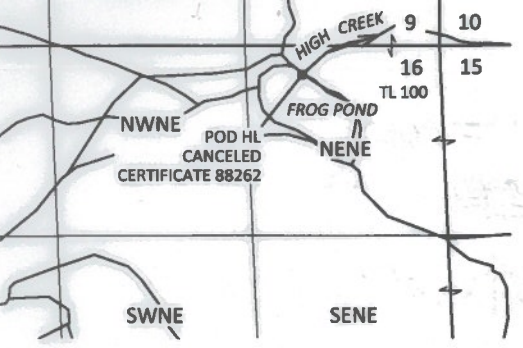

POD INSET MAP  
CANCELED CERTIFICATE 88261  
SECTION 27, T13S, R24E, W.M.

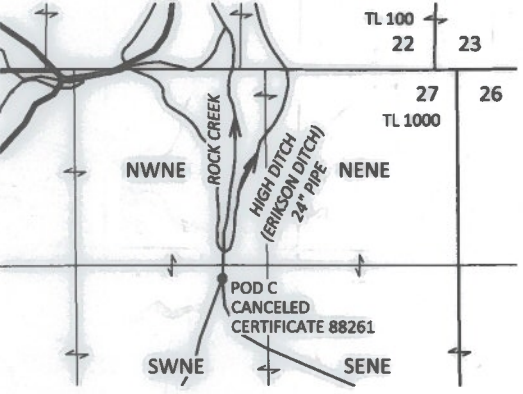

High Creek POD located 480 feet south and 1,220 feet east from NW corner of Section 14

Upper Stice Ditch POD located 1,960 feet south and 2,300 feet west from N 1/4 corner of Section 14


POD C located 1,460 feet south and 1,020 feet east from the N 1/4 corner of Section 27

POD LL located 3,380 feet south and 2,440 feet west from N 1/4 corner of Section 14

POD HL located 210 feet south and 940 feet west from NE corner of Section 16

RECEIVED  
JUN 05 2019  
OWRD

*John R. Bruce*  
Expires 12/31/2019

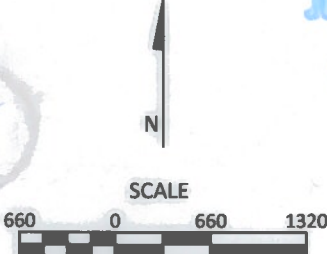

May 21, 2019

This map is not intended to provide legal dimensions or locations of property ownership lines

Figure 1

**SKOOKUM**  
WATER ASSOCIATES INC  
1626 VICTORIAN WAY  
EUGENE, OR 97401  
(503) 319-8926