


T.6S.R.3W.W.M.

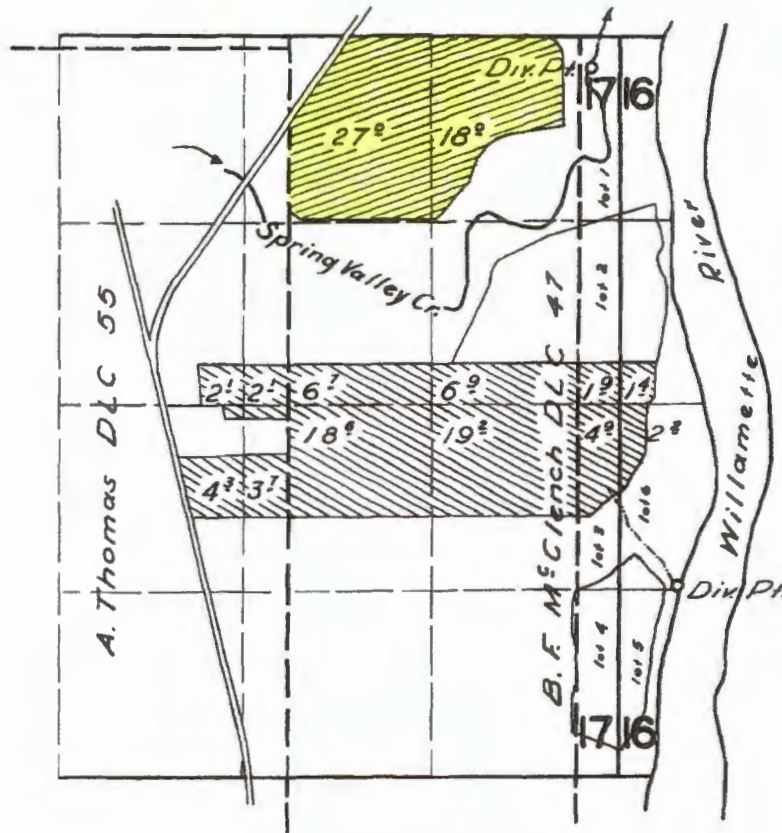

Diminution C. 24130  
**FINAL PROOF SURVEY**  
 UNDER

RECEIVED  
 NOV 06 2019  
 OWRD

Application No. 27065 Permit No. 21295  
 29870 23578  
 IN NAME OF



FRANK B. WINDSOR

Surveyed Nov. 2, 1956, by Mr. Bish