

APPLICATION: G 17563 PERMIT G 17035

FINAL PROOF SURVEY
 FOR
DAVID & ELLEN DRELL
6150 HEARST-WILLITS RD
WILLITS, CA. 95490
707-459-2643

POINT OF DIVERSION #1 LOCATION
 SOUTH 5003 FT & WEST 2296 FEET FROM
 NORTHEAST CORNER SECTION 20
 METER LOCATED AT DIVERSION POINT




DENOTES AREA OF BENEFICIAL USE

BY
H. TIMOTHY FASSBENDER, PLS, CWRE
2896 SARAH LANE
EUGENE, OR 97408
541-485-3136

NOTE

THIS MAP WAS PREPARED FOR THE PURPOSE
 OF IDENTIFYING THE LOCATION OF THE WATER
 RIGHT ONLY. IT IS NOT INTENDED TO PROVIDE
 DIMENSIONS OR LOCATION OF PROPERTY
 OWNERSHIP LINES.

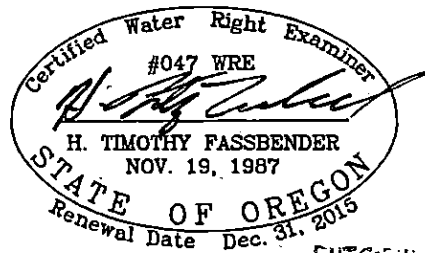

RECEIVED BY OWRD

DEC 10 2015

SALEM, OR